

72527

RECEIVED IN HOOKING COUNTY, OHIO
at 11:27 O'CLOCK A.M.
RECORDED May 9 1988
RECORD #1 VOL. 2 PAGE 54


MAY 09 1988

Donna R. Feach
RECORDER - HOOKING COUNTY
LOGAN, OHIO 43138

NOTE

DR. HAYWARD'S OFFICE - APPROX. 1496 SQ.FT.

DR. GAY'S OFFICE - APPROX. 1381 SQ.FT.

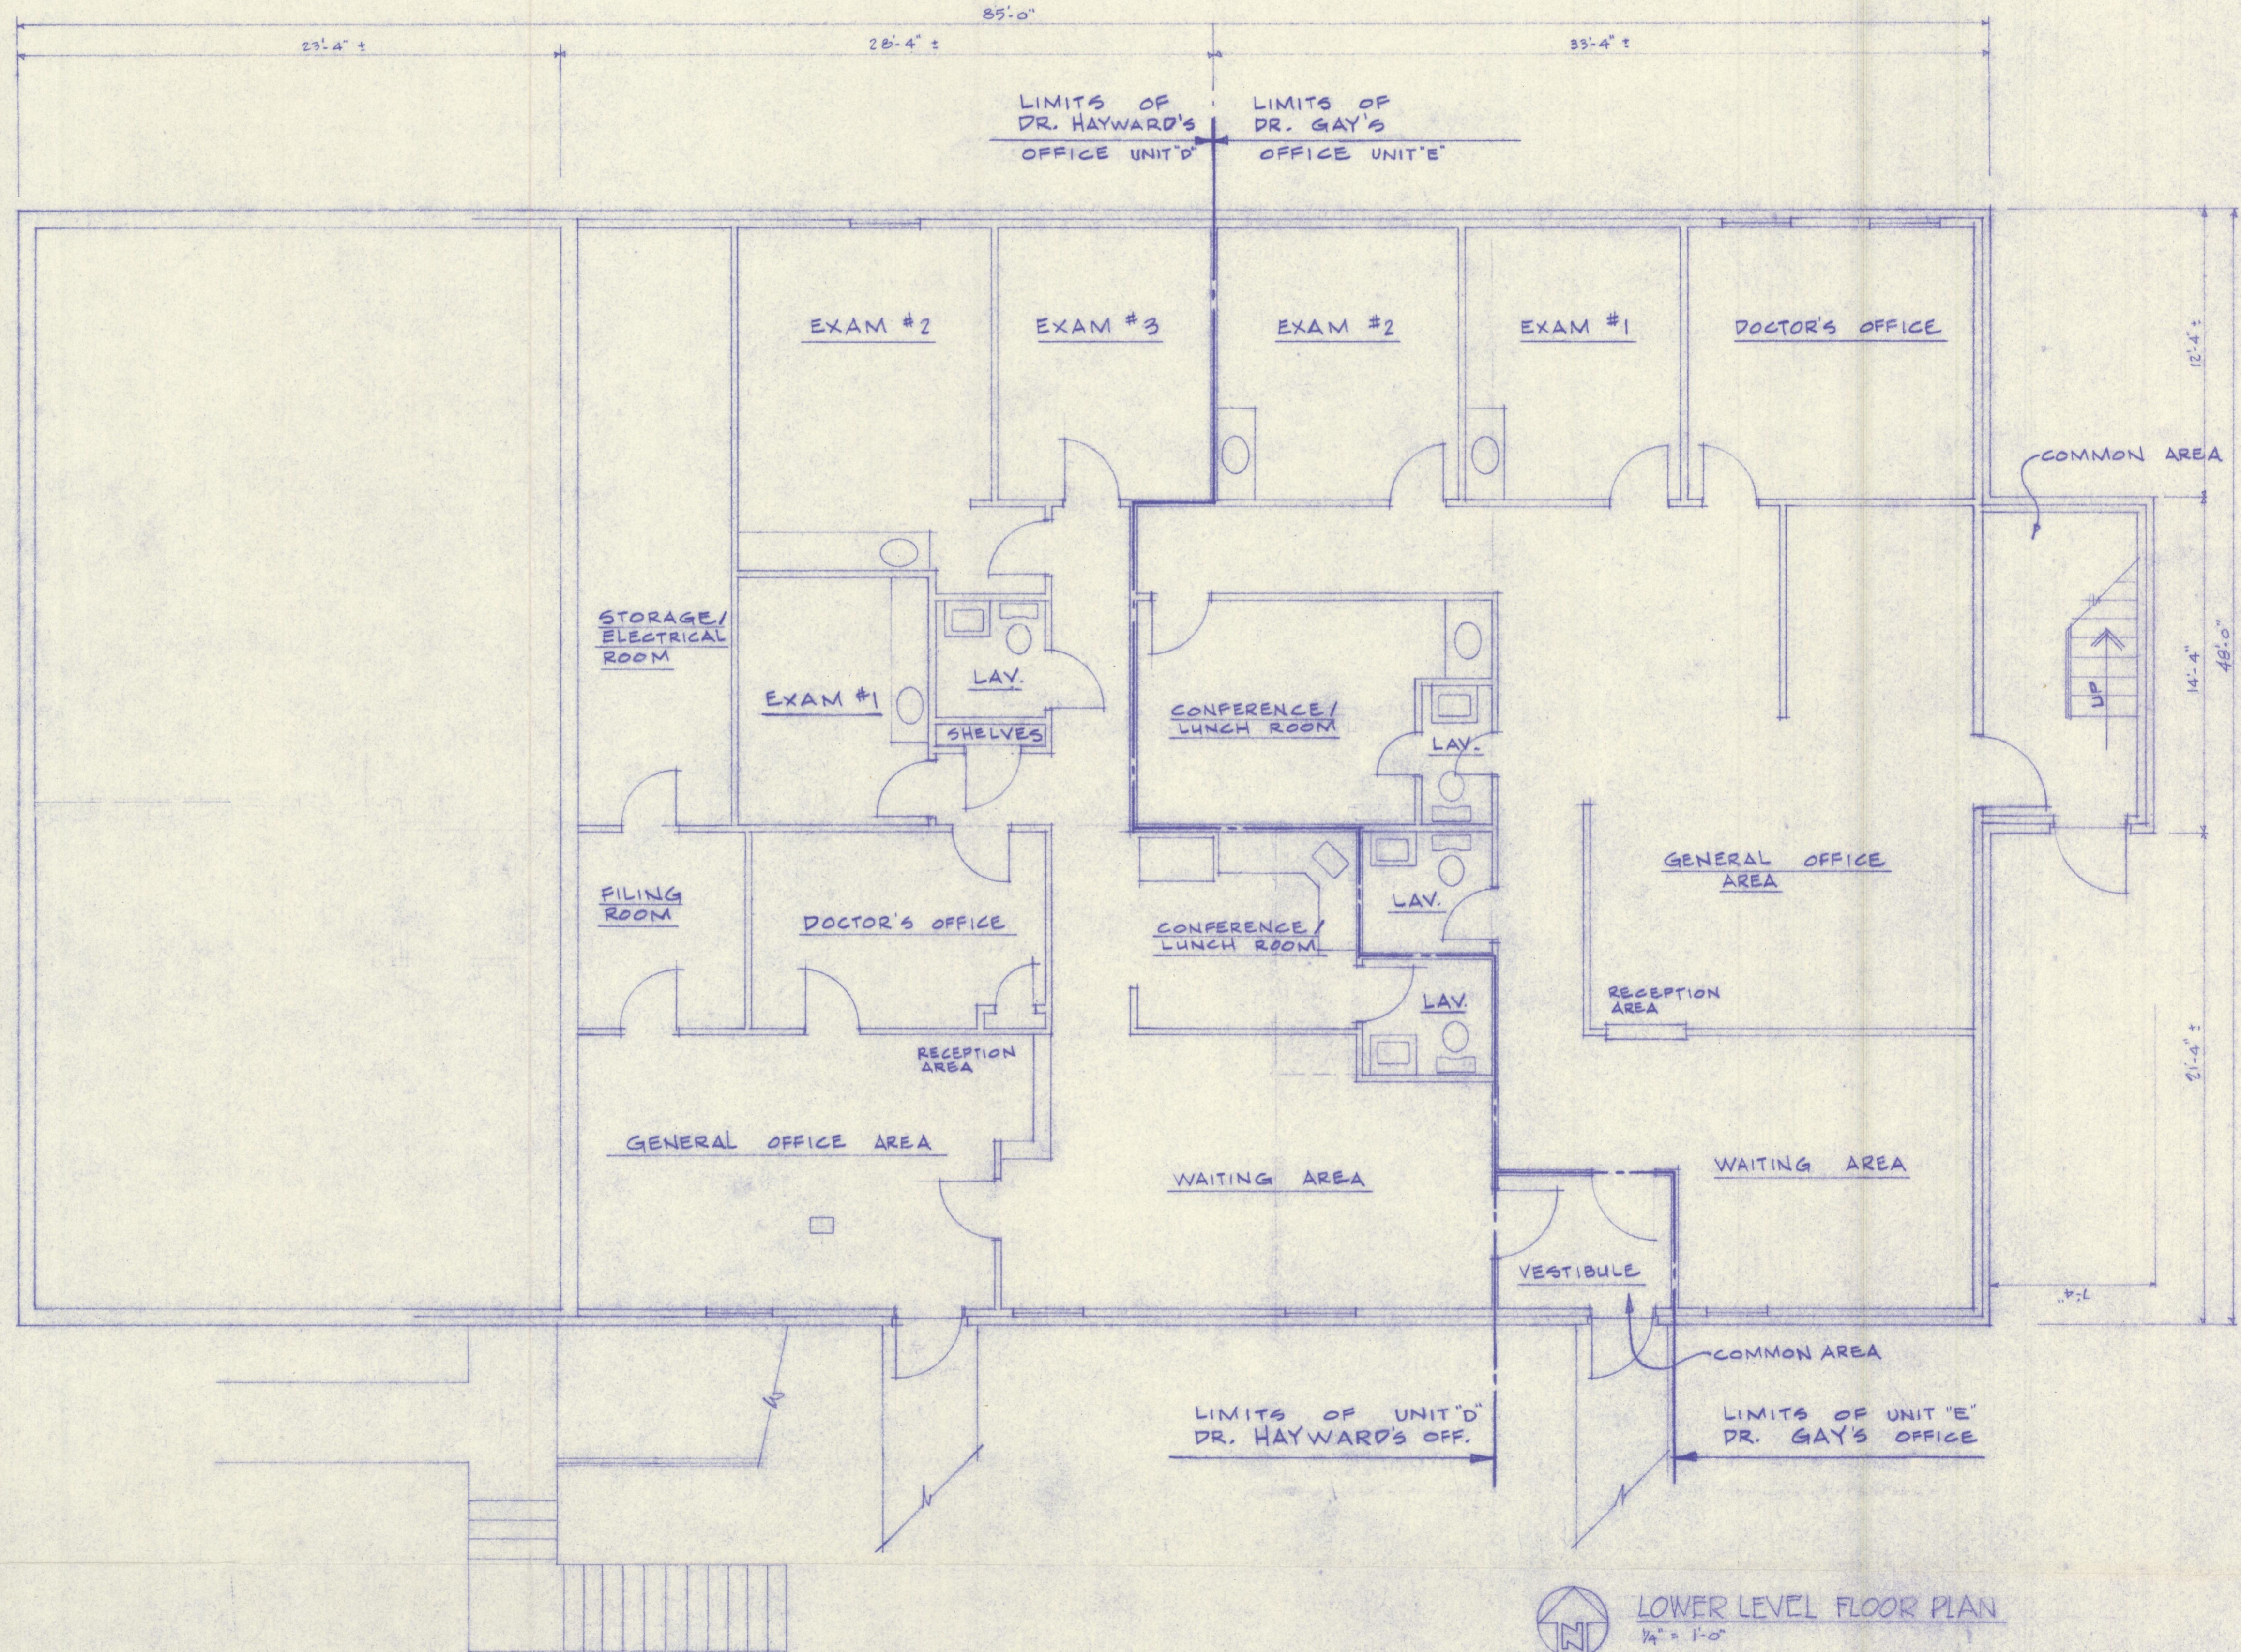

OFFICE AREA ANALYSIS - LOWER LEVEL

UNIT "D" 1272 S.F.
UNIT "E" 1312 S.F.


CERTIFICATION

TO THE BEST OF MY KNOWLEDGE THE DRAWINGS ACCURATELY SHOW THE BUILDING AS CONSTRUCTED.

James A. Monsul
JAMES A. MONSUL - ARCHITECT - REG. NO. 6889
4.5.88




LOWER LEVEL FLOOR PLAN
1/4" = 1'-0"

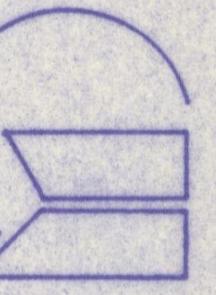

LOWER LEVEL FLOOR PLAN

ALTERATIONS TO EXISTING
PHYSICIAN'S OFFICE BUILDING

751 STATE ROUTE 664 NORTH
LOGAN, OHIO 43138

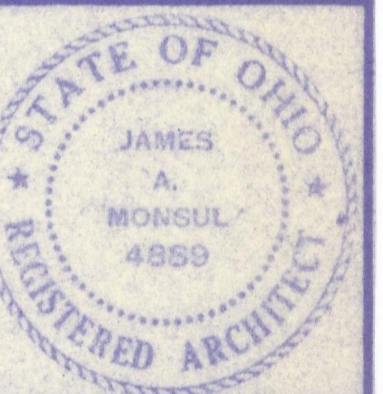

2-10-88