

RELOCATION Co. Rd. 11

ISSUE I

F.H.W.A. REGION	STATE	PROJECT
	OHIO	ISSUE I

HOCKING CO. RD. 11


STATE OF OHIO
 DEPARTMENT OF ~~HIGHWAYS~~ TRANSPORTATION
 COUNTY ROAD 11
 LAUREL TOWNSHIP
 HOCKING COUNTY

Proposed
Never Approved

CONVENTIONAL SIGNS

Township Line		
County Line		
Center Line		
Property Line		
Fence		
Guard Rail	Existing	Proposed
Trees		
Right of Way	Existing	Proposed
Railroad		
Drain Pipe	Existing	Proposed

Design - Design

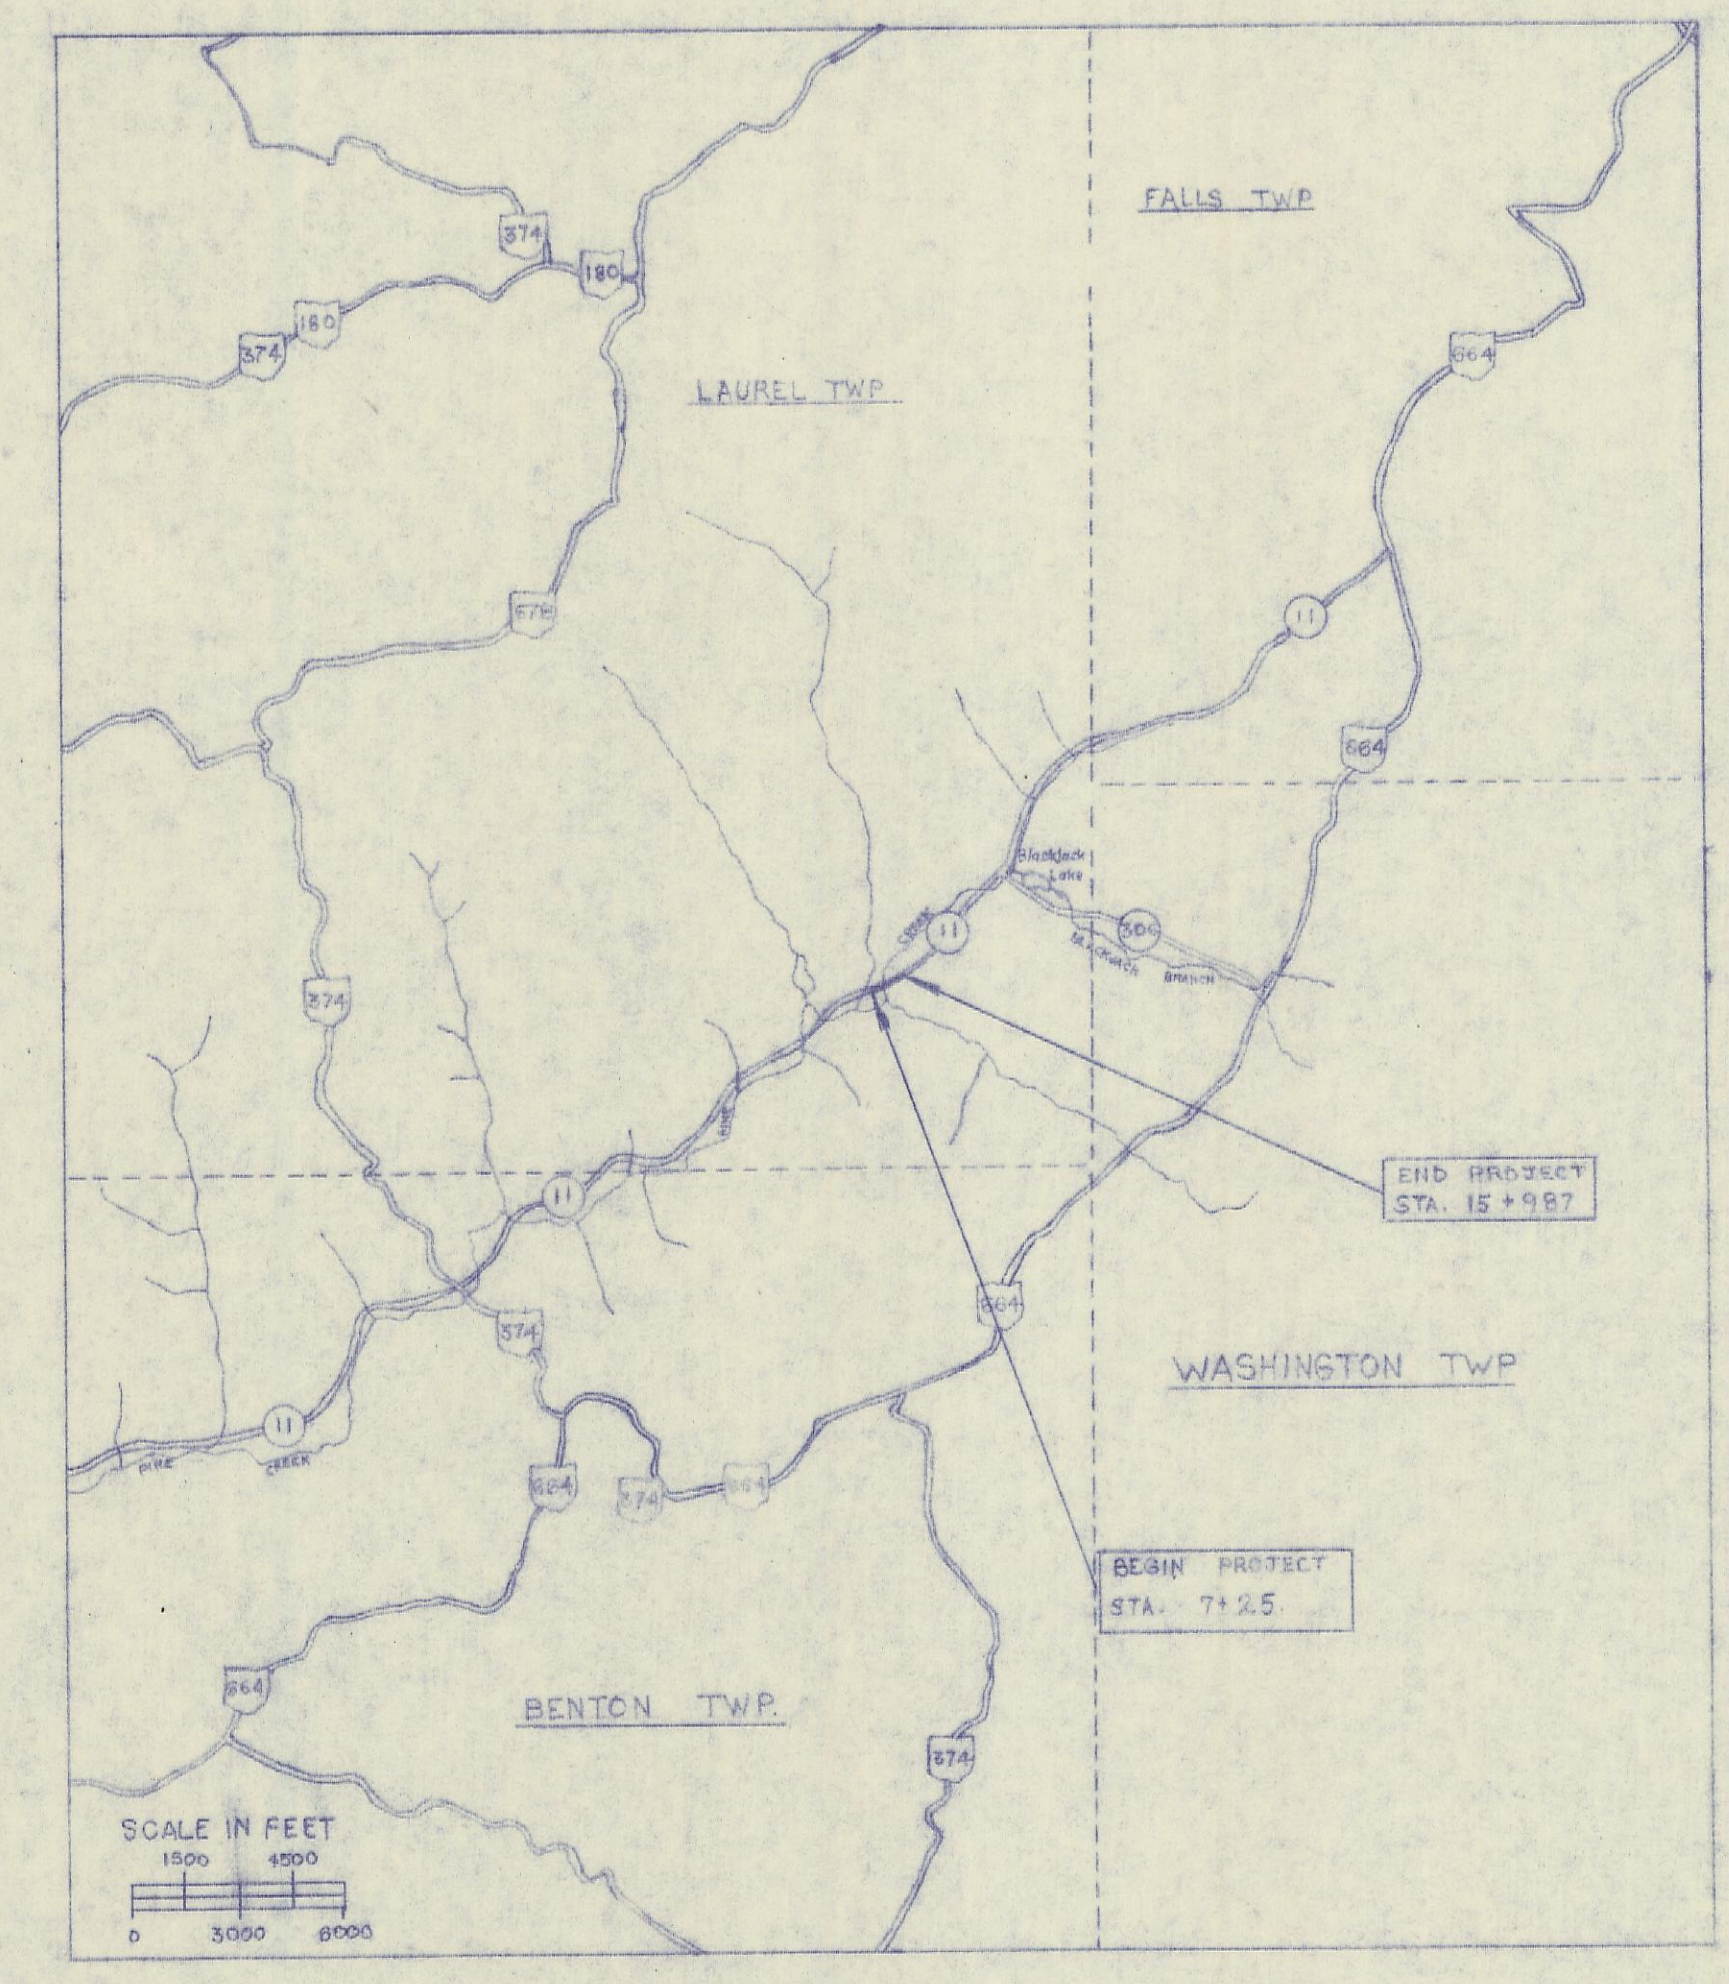

~~STATE ISSUE I~~
77 ~~FOUNDED PROJECT~~
15th Specifications


We the Commissioners of Hocking County, Ohio, in formal session hereby approve these plans and certify that the necessary right of way is available. We agree to maintain the project in a manner satisfactory to the Director of Highways, State of Ohio, or his duly authorized representatives, and will make ample provisions each year for such maintenance and repair.

Done under authority of Sections 5555-02 et. seq. and 5535-01 et. seq. of the Revised Code of Ohio, Board of Commissioners, Hocking County,

Date _____

The standard specification of the State of Ohio Department of Highways, including changes and supplemental specifications listed in the proposal shall govern this improvement.

Approved _____ Date _____	County Engineer _____
Approved _____ Date _____	Division Deputy Director _____
Approved _____ Date _____	Deputy Director of Planning and Programming _____
Approved _____ Date _____	Engineer of Bridges _____
Approved _____ Date _____	Engineer of Location and Design _____
Approved _____ Date _____	Deputy Director of Design and Construction _____
Approved _____ Date _____	First Asst. Director _____
Approved _____ Date _____	Director of Highways _____

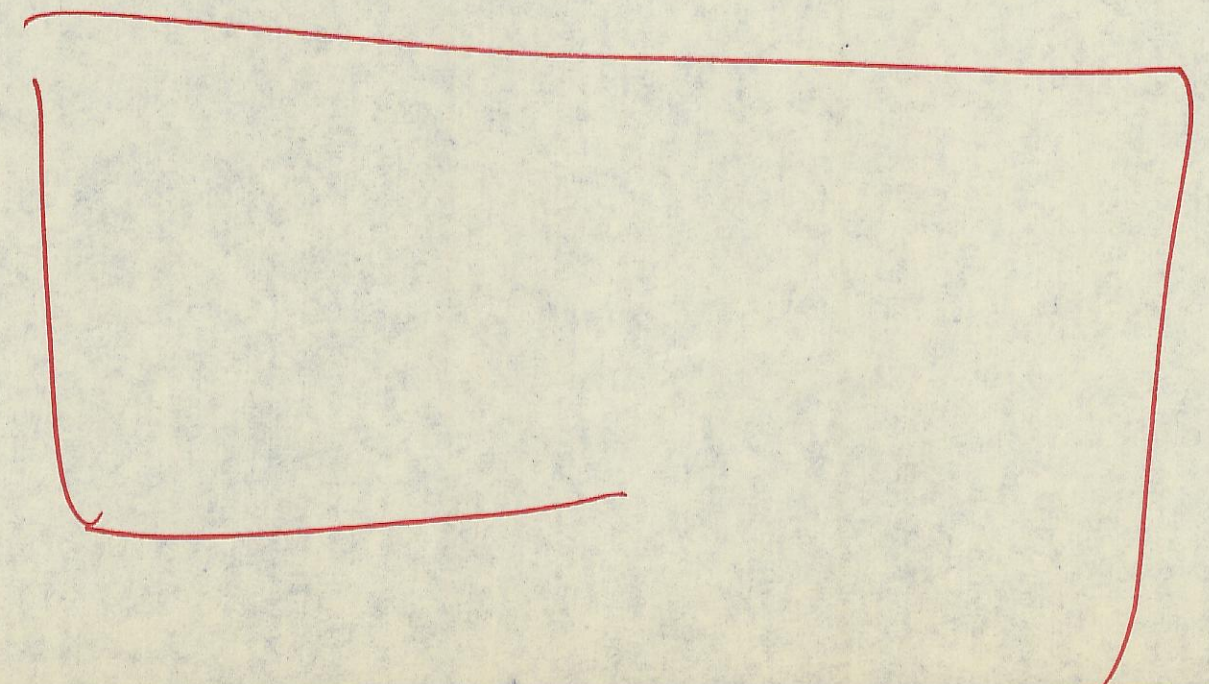

Drawn by
Approved