

HOCKING COUNTY STATE OHIO
SECTION NO. 2 TWP. 12 RANGE 19
PERRY

SCALE: 500 FEET TO 1 INCH

Perry
Twp 13
34

Original A.W.S. Red 11145

North

Note Sec 2 is short on N & S Lines

Township 13 Line -

35

Perry
Twp 13
36

Romeo Nida
W $\frac{1}{2}$ of NW $\frac{1}{4}$ 72 ac

Geo C Smith
E $\frac{1}{2}$ NW $\frac{1}{4}$ 68ac

Cook Smith
NW $\frac{1}{4}$ of NE $\frac{1}{4}$ 36 ac.

L.M. Tabler 13
Total Tax Acreage 20ac

AEGI
Ken

35 / 8

86.48

J.W. & m Collins

J. M. Ferguson
SW ¼ of NE ¼ 40ac.

Chas Pinkstock
Tax Acreage 46 ac.
Deed acreage 43 ac

C&R MURPHY
Marshall ~~Dowds~~
NW 1/4 of SW 1/4 34 ac
Tax Dpt. 36ac

Clyde Caviness ✓
NW $\frac{1}{4}$ of SE $\frac{1}{4}$ & NE $\frac{1}{4}$ of NW $\frac{1}{4}$ 62.88ac
tax duplicate 72ac.

Clyde Cavinee
29.ac (indefinite)

H. C. V. M. 12
18.24

10

Isaac Pinkstock
SE $\frac{1}{4}$ of SW $\frac{1}{4}$ 36 ac.

E. MASON

Jennie Terry et al
Lot 1 2.00ac
Deed Acreage 25 1/2
Total Tax Dupl. 36.50ac

3

30

三〇二

PERRY 2

HOCKING COUNTY STATE OHIO
SECTION NO. 3 TWP. 12 RANGE 19
PERRY

SCALE: 500 FEET TO 1 INCH

Perry
Twp 13

33

4

12.85

15.0

15.16

11.07

4

9

A.W. Seabright Original Feb 6 1939

Note Sec. 3 is short on N&S Lines.


Perry
Twp 13

34

2

35

2

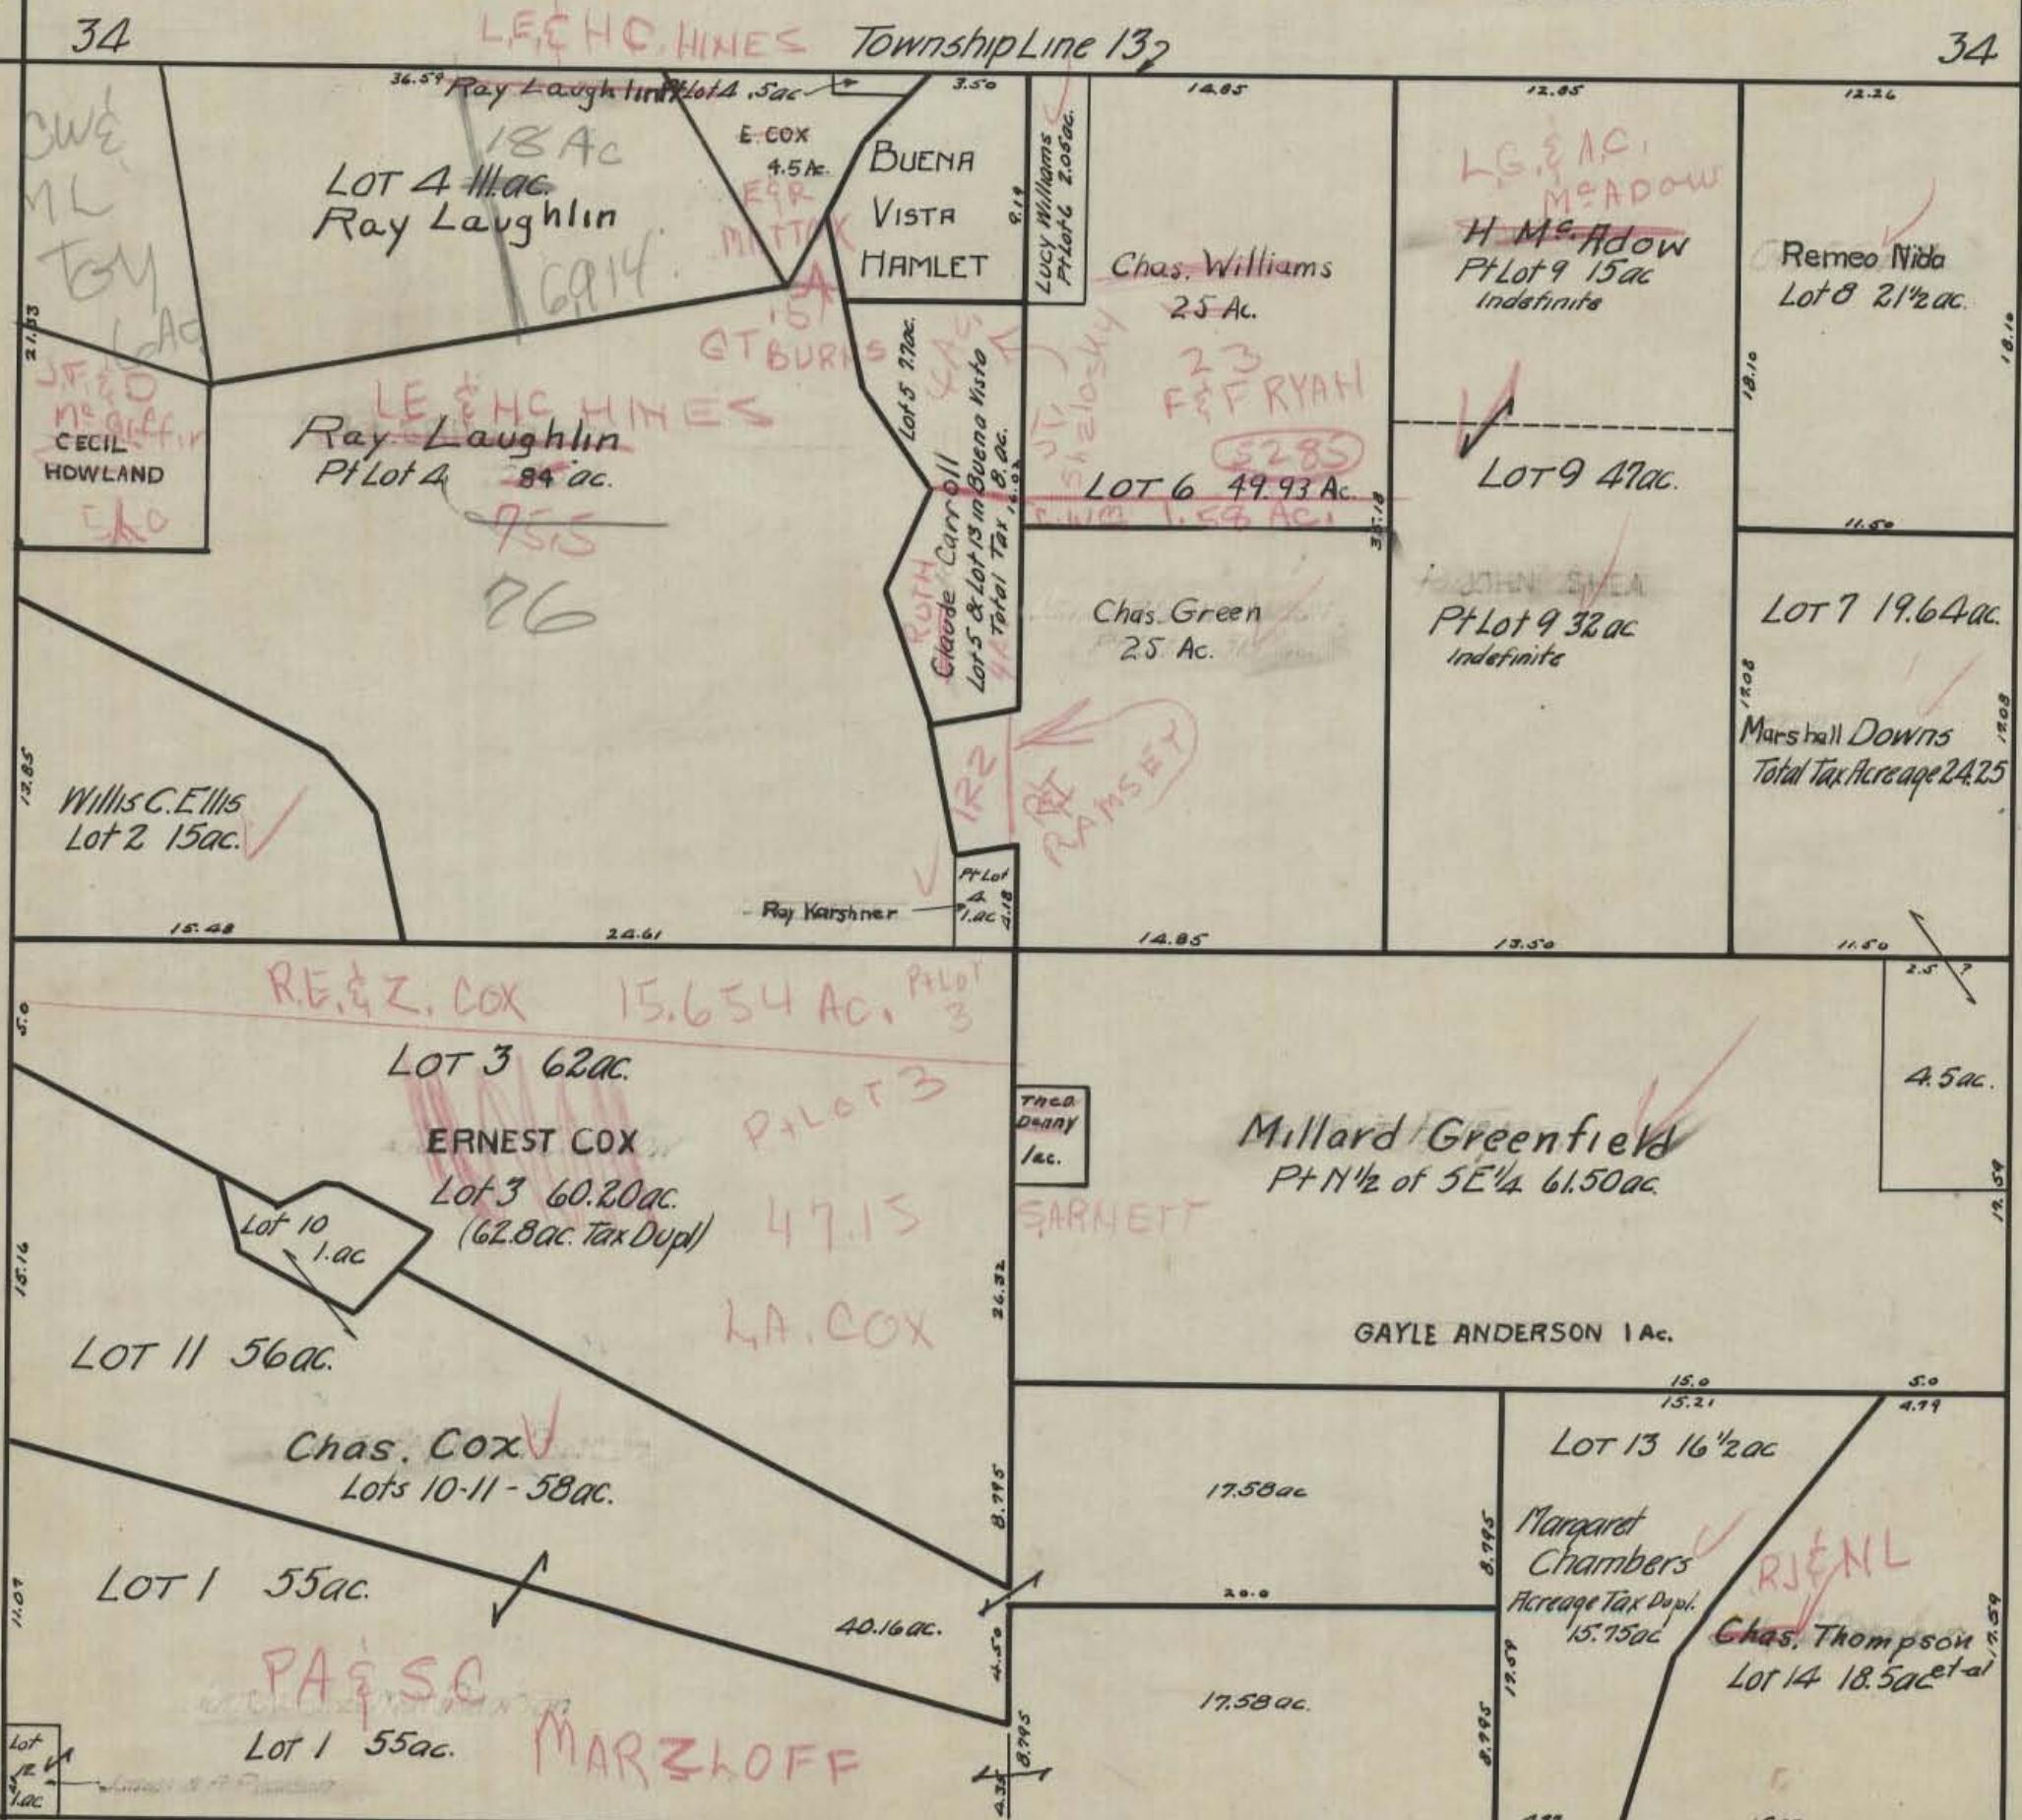

PERRY 3

10

11

HOCKING COUNTY STATE OHIO
SECTION NO. 4 TWP. 12 RANGE 19
PERRY

SCALE: 500 FEET TO 1 INCH

Perry
Twp 13

33


A.W.Seabright Original Feb 10 '39

North

Section is short on N & S Lines

四
一

Perry
Twp 13
31

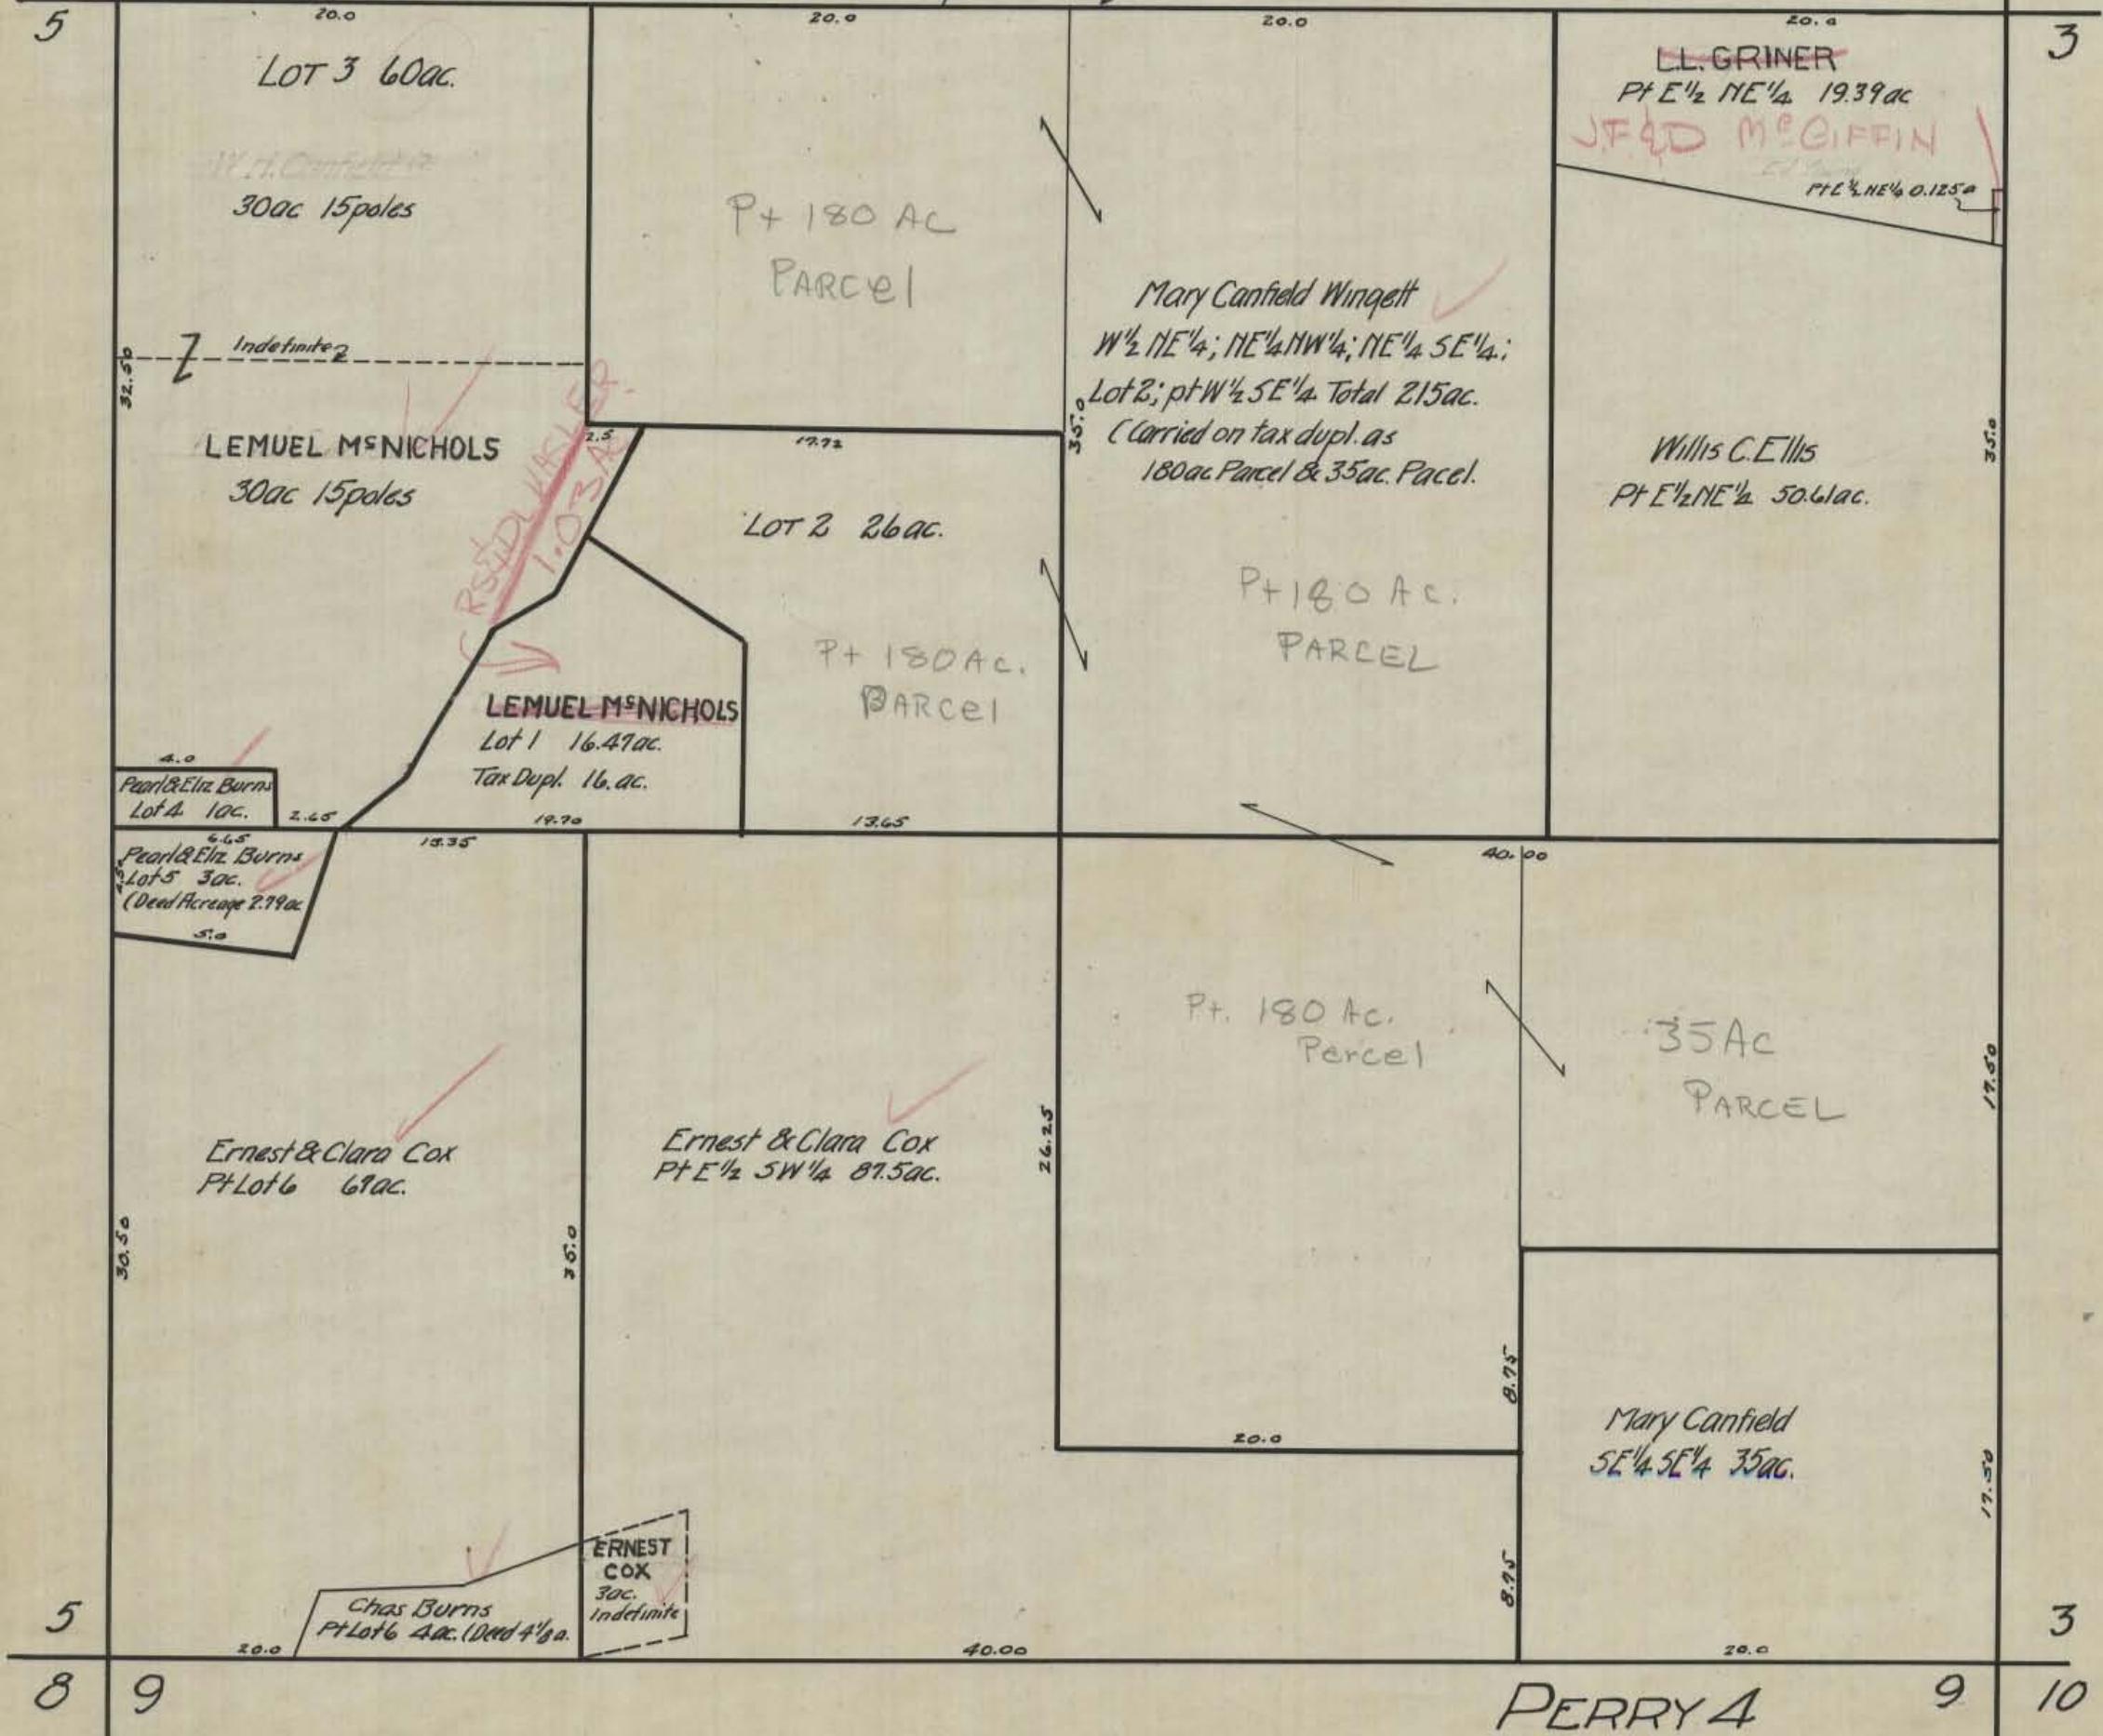

A.W.S Original Feb 13 1939

HOCKING COUNTY STATE OHIO
SECTION NO. 5 TWP. 12 RANGE 19
PERRY

SCALE: 500 FEET TO 1 INCH

Perry
Twp 13
31

Section is short on N&S Lincs

North


Perry
Twp 13
33

32

32

6


4

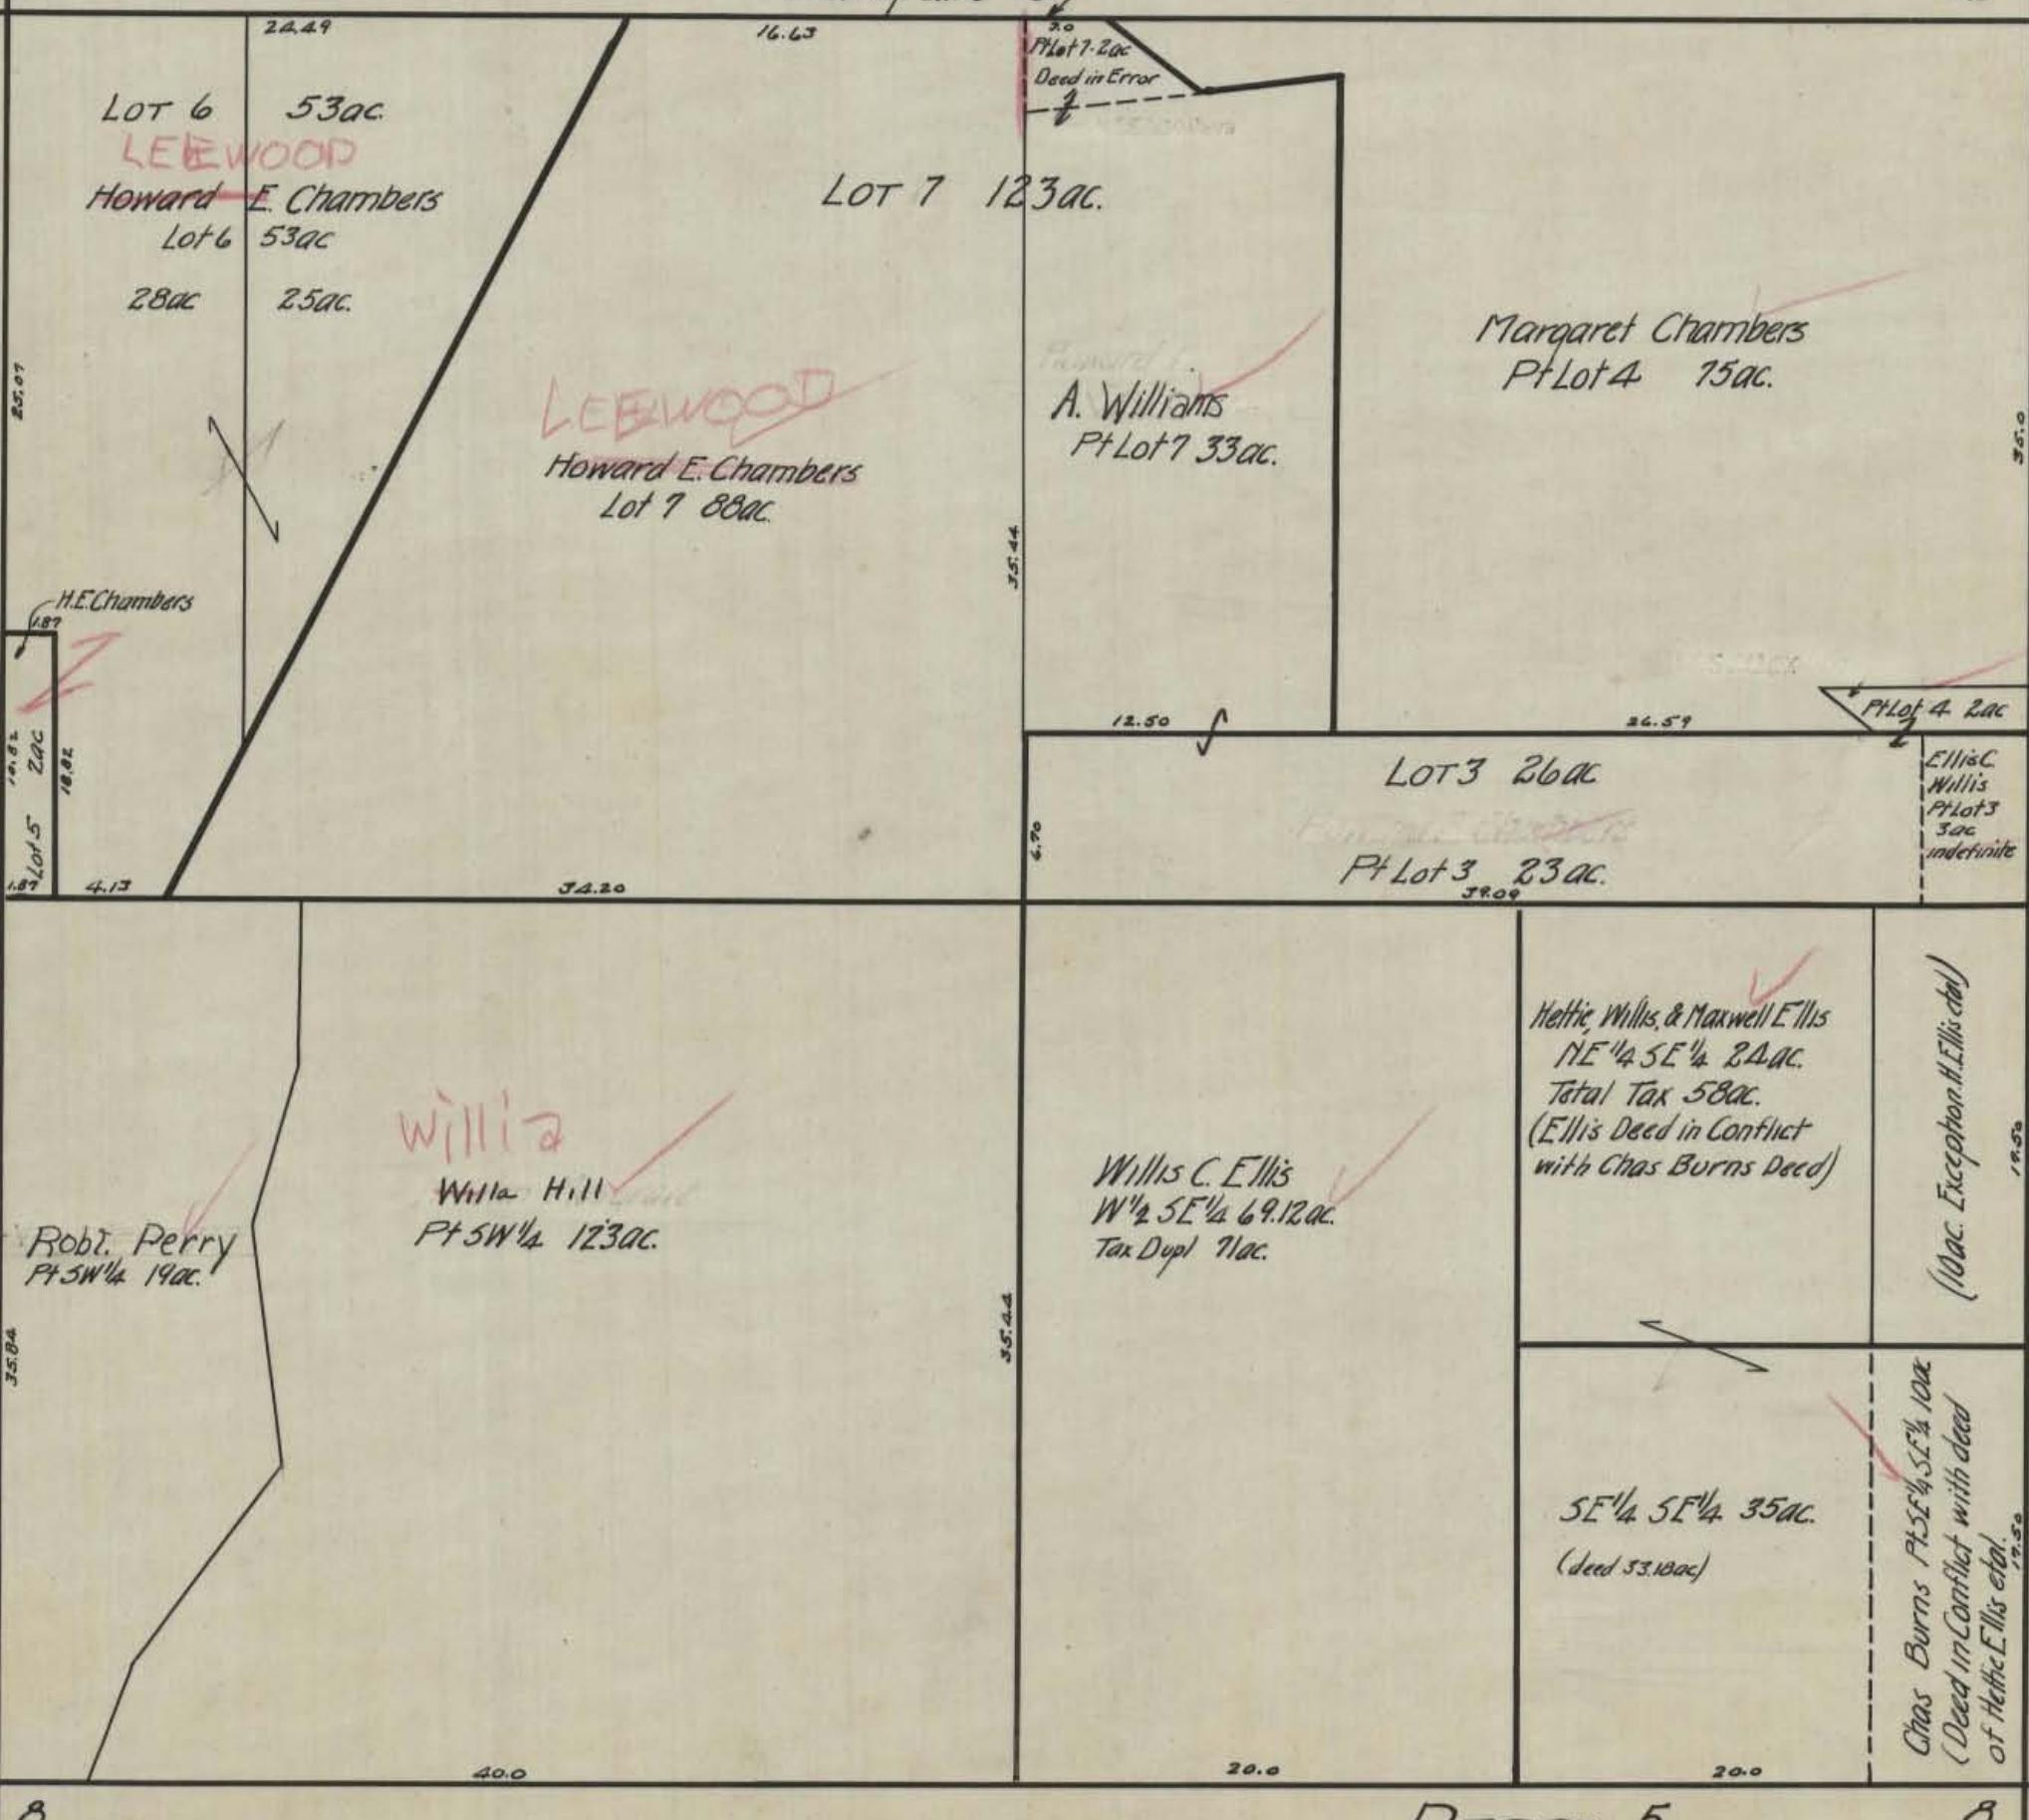

Ong A.W.S Feb 15 1939

HOCKING COUNTY STATE OHIO
SECTION NO. 6 TWP. 12 RANGE 19
PERRY

SCALE: 500 FEET TO 1 INCH

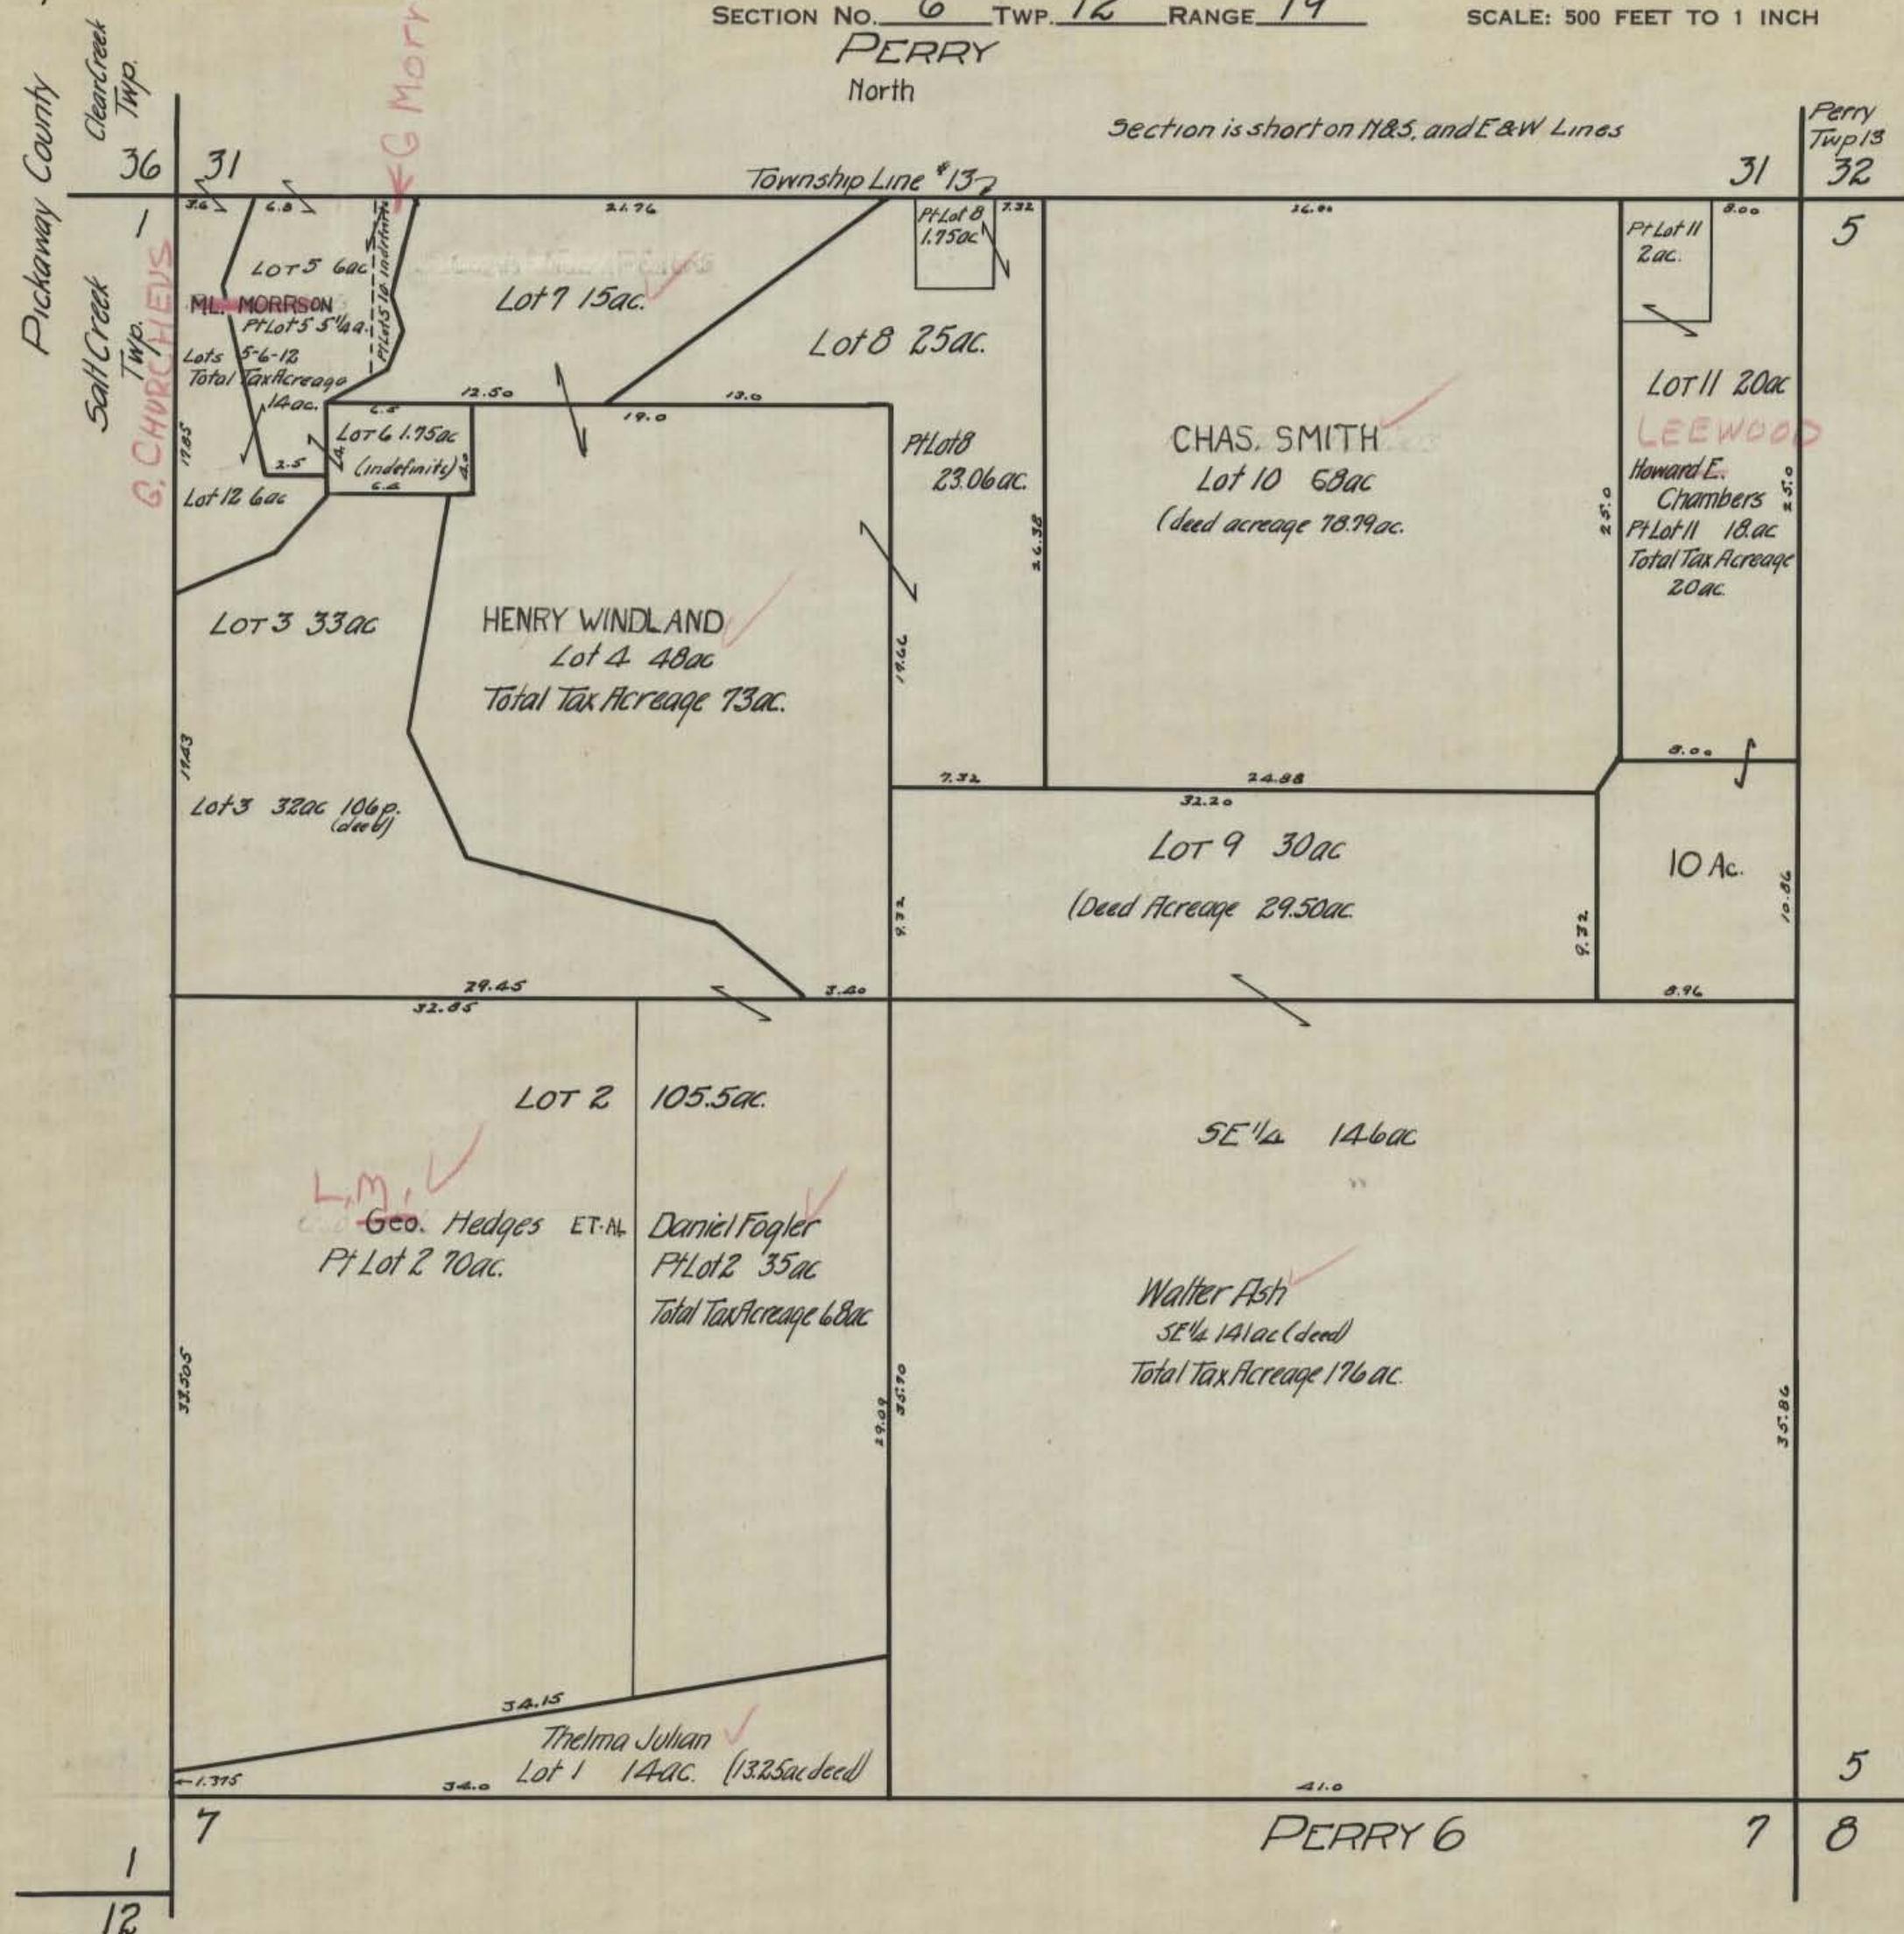

HOCKING COUNTY STATE OHIO

R.W.Seabright Orig. Feb 15 1939

SECTION NO. 7 TWP. 12 RANGE 19

PERRY

North

SCALE: 500 FEET TO 1 INCH

6

6

5

1

12

8

LOT 4 28ac

Thelma & Muriel M. Julian
Lot 4 28.50 (deed)

34.05

LOT 3 151ac.

WILMA LINDSEY
James P. Schaad
Pt Lot 3 79.04ac.C.H. & S.M. HANES
Geo & Ernest Cox
Pt Lot 3 74.96ac.

6

13.0

27.0

5

LOT 5 17ac

8.22 1/4

13.05

13.05

10.0

10.0

HOCKING COUNTY STATE OHIO
SECTION NO. 8 TWP. 12 RANGE 19

SCALE: 500 FEET TO 1 INCH

6 5 Corrected AWS Feb 16 1939

PERRY
North

5 4

6

7

9

6.5ac
GOLDA
HILLIARD
W B & E E

HENESTOFEL

20.0

20.0

20.0

15.0
Chas Burns 1.5ac
Chas Burns .5ac

LOT 2
2 ac.
3.0
4.0

(44.90)

(68.85ac)

20.0

O.W. Detong
Total Map Acreage 154ac.
Listed on Tax Duplicate as
54ac + 33.5ac + 67ac
Total Tax Acreage 154.5ac.

FL & LG SMITH

W 1/2 NE 80ac.

LOT 4 173ac.

4.0

DENVER WINLAND
40ac
Total Tax Acreage 46.50ac

(11.15)

20.0

20.0

1.50

76.0

LOT 3 95ac

11 1/2 E 1/2 SW 1/4 40.25ac

Eldon Fish
W 1/2 SW 1/4 80ac.

40.0

A&I HUNT

Walter Julian
5 1/2 E 1/2 SW 1/4 41.25ac (deed)
(40.25ac Tax dupl.)

About 15ac No Ownership Listed in Tax Duplicate
Deed in conflict with Benj Julian Lot 2.
LD & FM DILLE

LLOYD CLARY
Lot 2 50ac.

About 21.5ac No Ownership Listed in Tax Dupl.

14.5ac
Acreage in conflict with
Benj Julian Lot 2.

20.0

23.75

27.50

4

9

7
18 17

PERRY 8

17 16

Corrected by A.W.S. Apr. 13, 1939

HOCKING COUNTY STATE OHIO
SECTION NO. 9 TWP. 12 RANGE 19
PERRY

NORTH

SCALE: 500 FEET TO 1 INCH

5
4

8

40.00

25.25

12.75

3

10

Ernest Cox
Pt NW $\frac{1}{4}$ 82ac.

Harley Hilliard
Lot 1 101ac.

R.E. & E.J.
ANDERSON

RONALD ROBINETTE
20Ac
PR&MC
GOOD

John M. Orey
Lot 2 - Two Parcels
39ac.
EARNEST COX

30
+ 9
39 Ac.

24 Ac.

CAGE J. DEITZEL
Berry Dunnigan
Pt NW $\frac{1}{4}$ 54ac.

WEST

EAST

D JR, E F

EDNA SHASTEN
SW $\frac{1}{4}$ 160ac.

MOSLEY

Rachael R Willis
HARRY SWORD
Pt SE $\frac{1}{4}$ 91.75ac.

40.00

William Friend
Pt SE $\frac{1}{4}$ 68.25ac.

SOUTH

40.00

PERRY 9

8

10

17 16

16

15


HOCKING COUNTY STATE OHIO
SECTION NO. 10 TWP. 12 RANGE 19

Corrected by A.W.Seabright Apr 14 1939

PERRY

NORTH

SCALE: 500 FEET TO 1 INCH

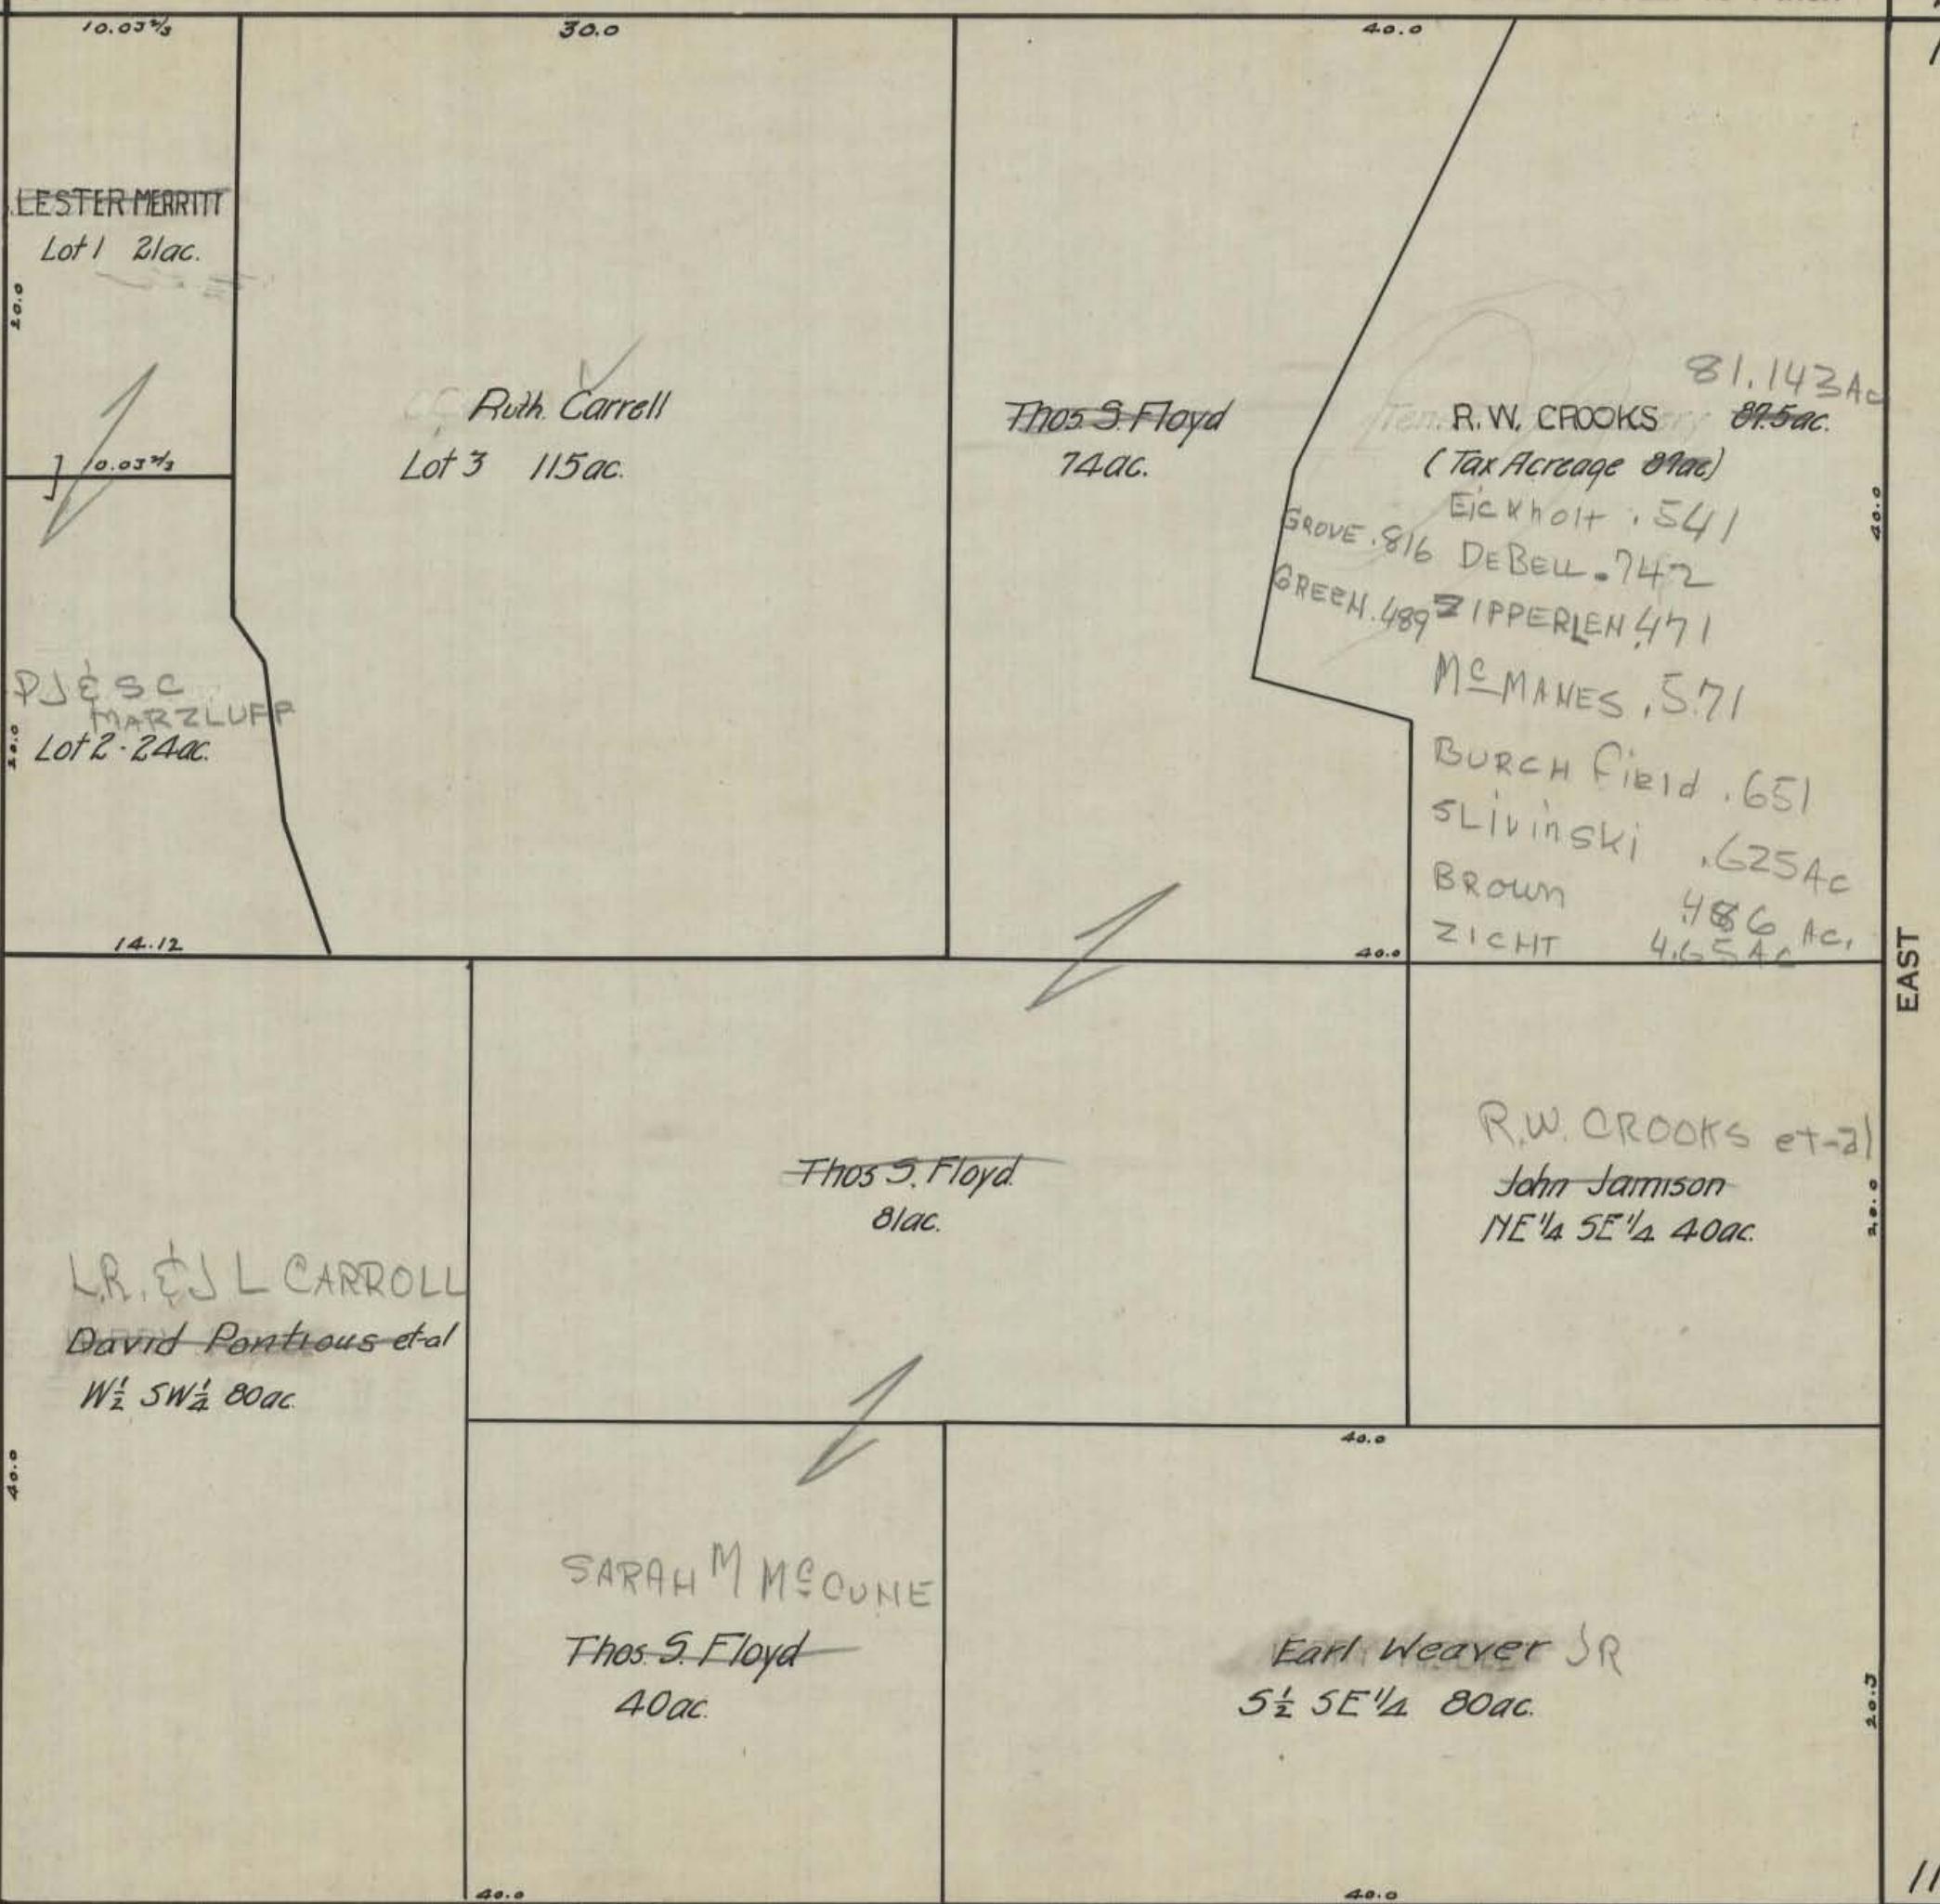

HOCKING COUNTY STATE OHIO

A.W.S 1944

SEC 11 TWP 12 RANGE 19


PERRY TWP



HOCKING COUNTY STATE OHIO
SEC 12 TWP 12 RANGE 19

ANNUAL 1944

PERRY TWP

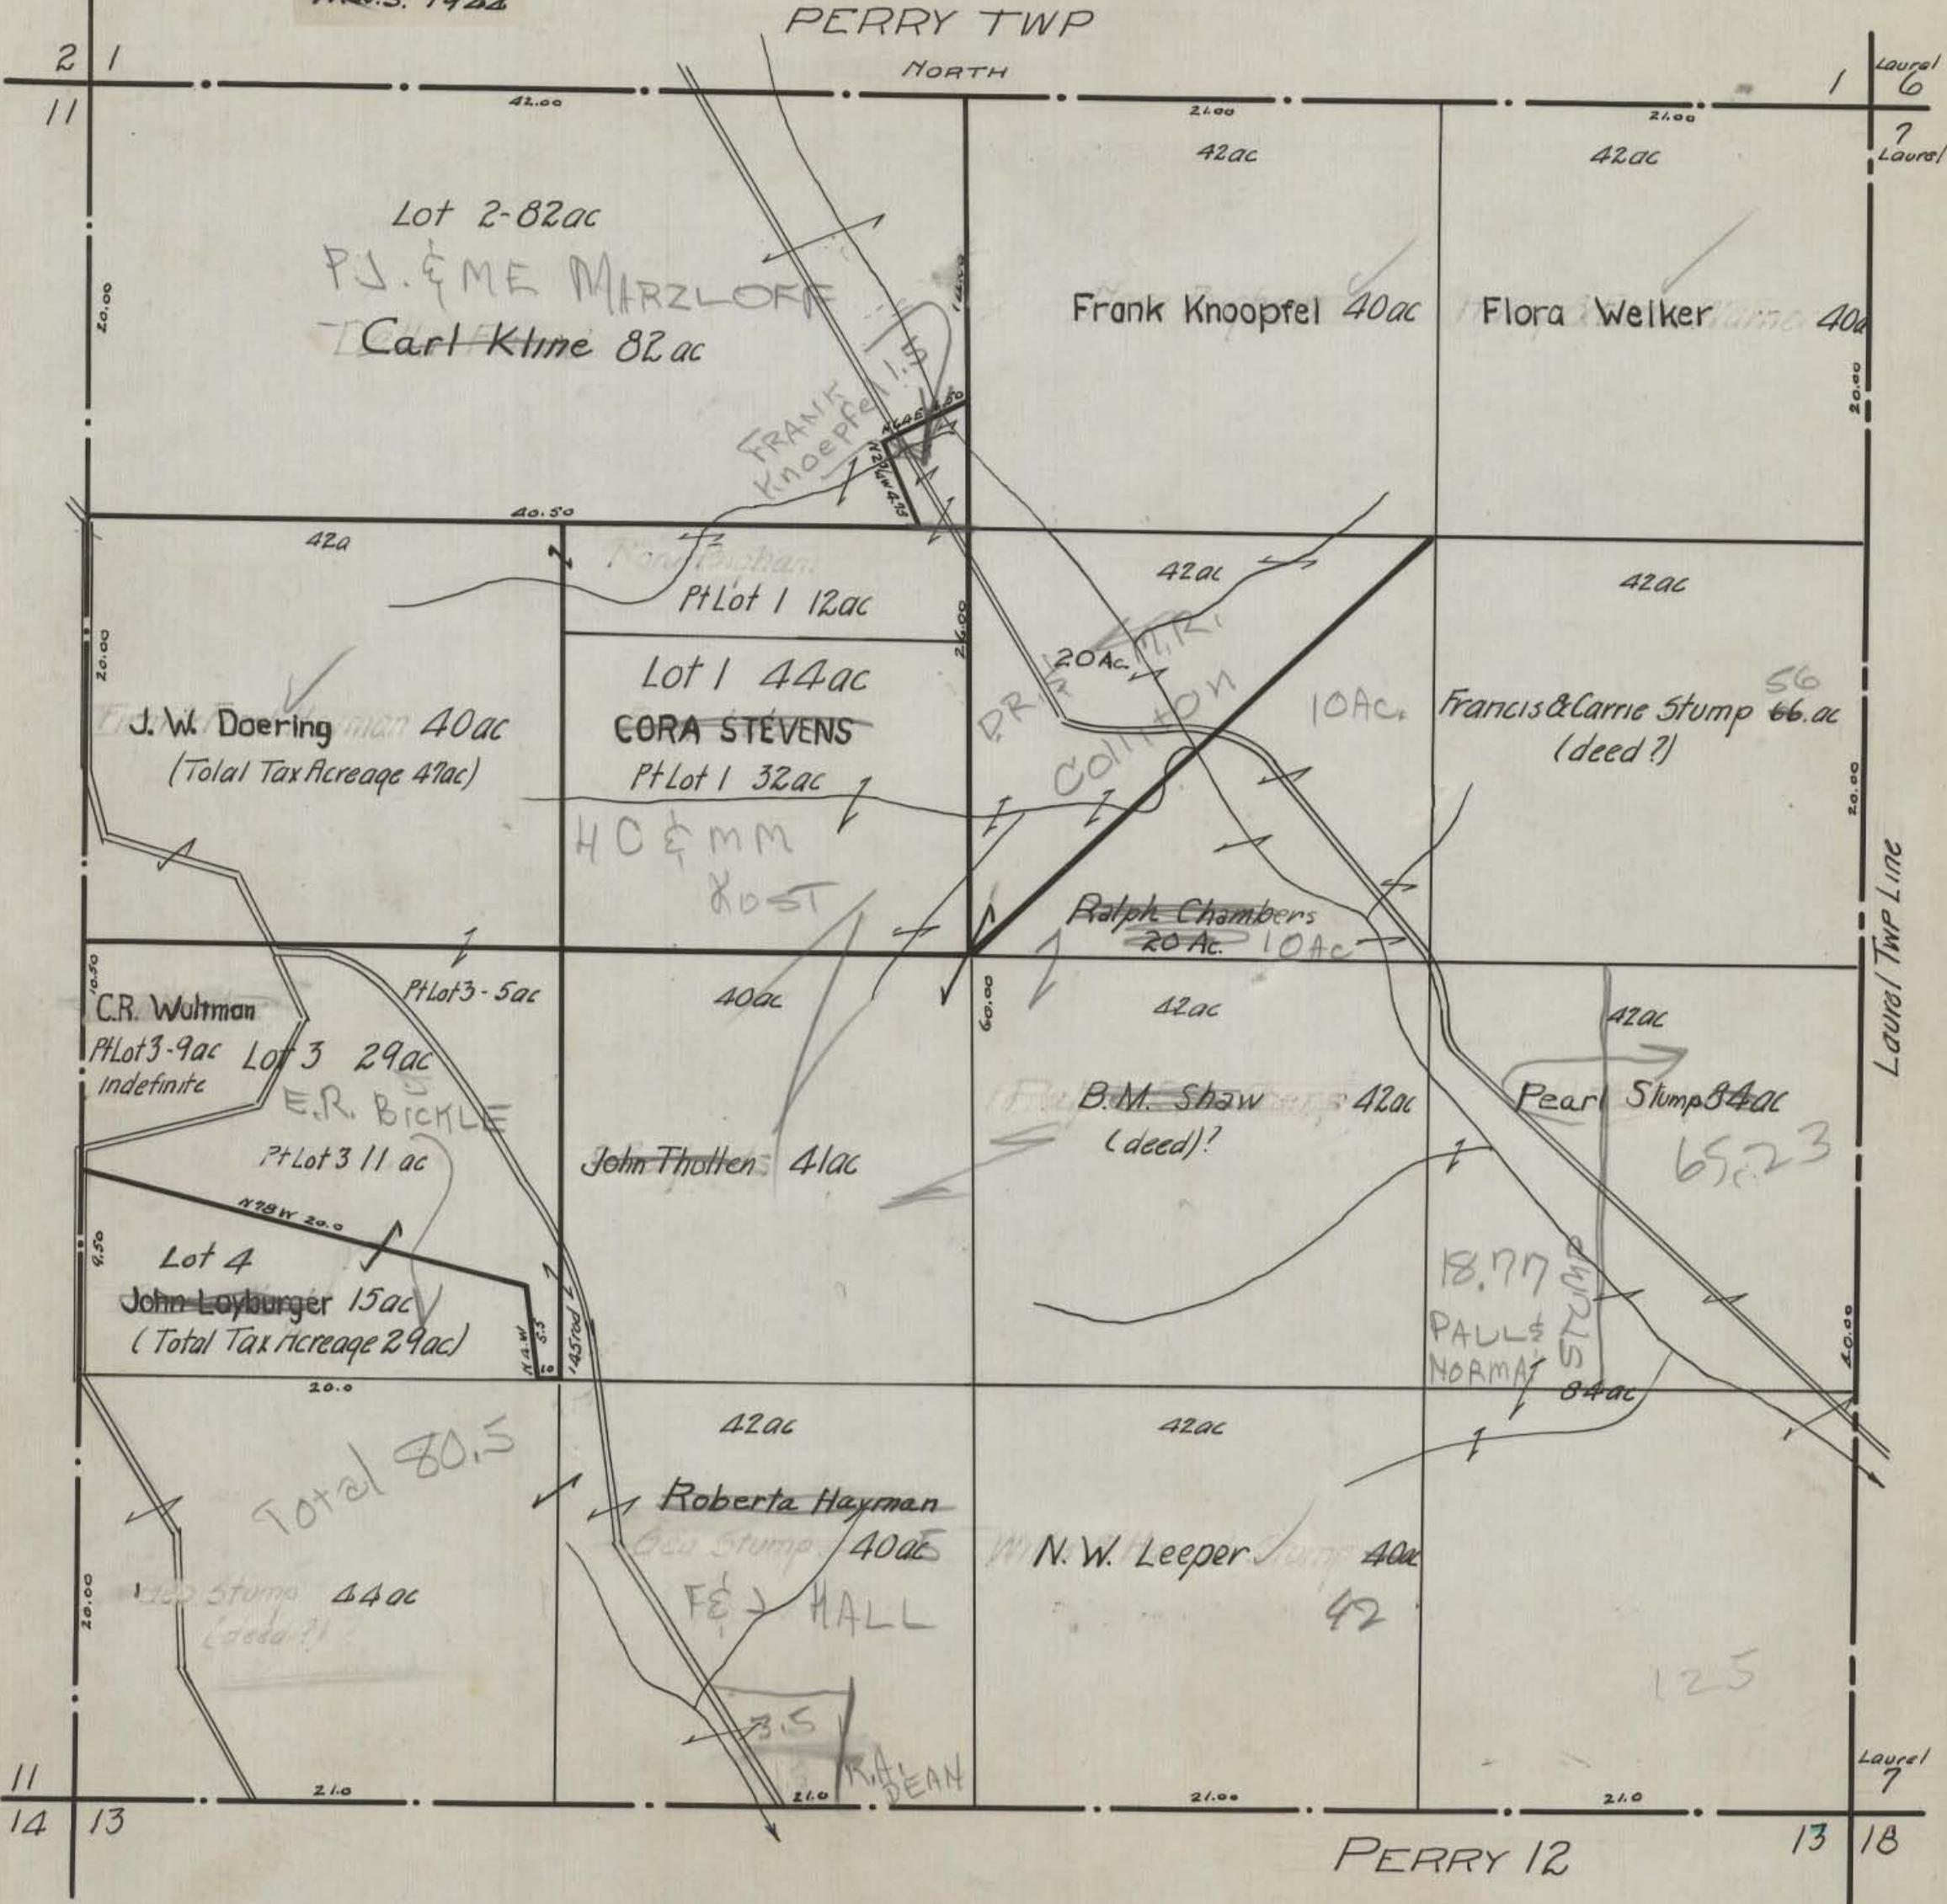

HOCKING COUNTY STATE OHIO
SEC. 13 TWP 12 RANGE 19
PERRY TWP




HOCKING COUNTY STATE OF OHIO

Orig 1944 AWS.

SEC 14 TWP 12 RANGE 19

PERRY TWP

North

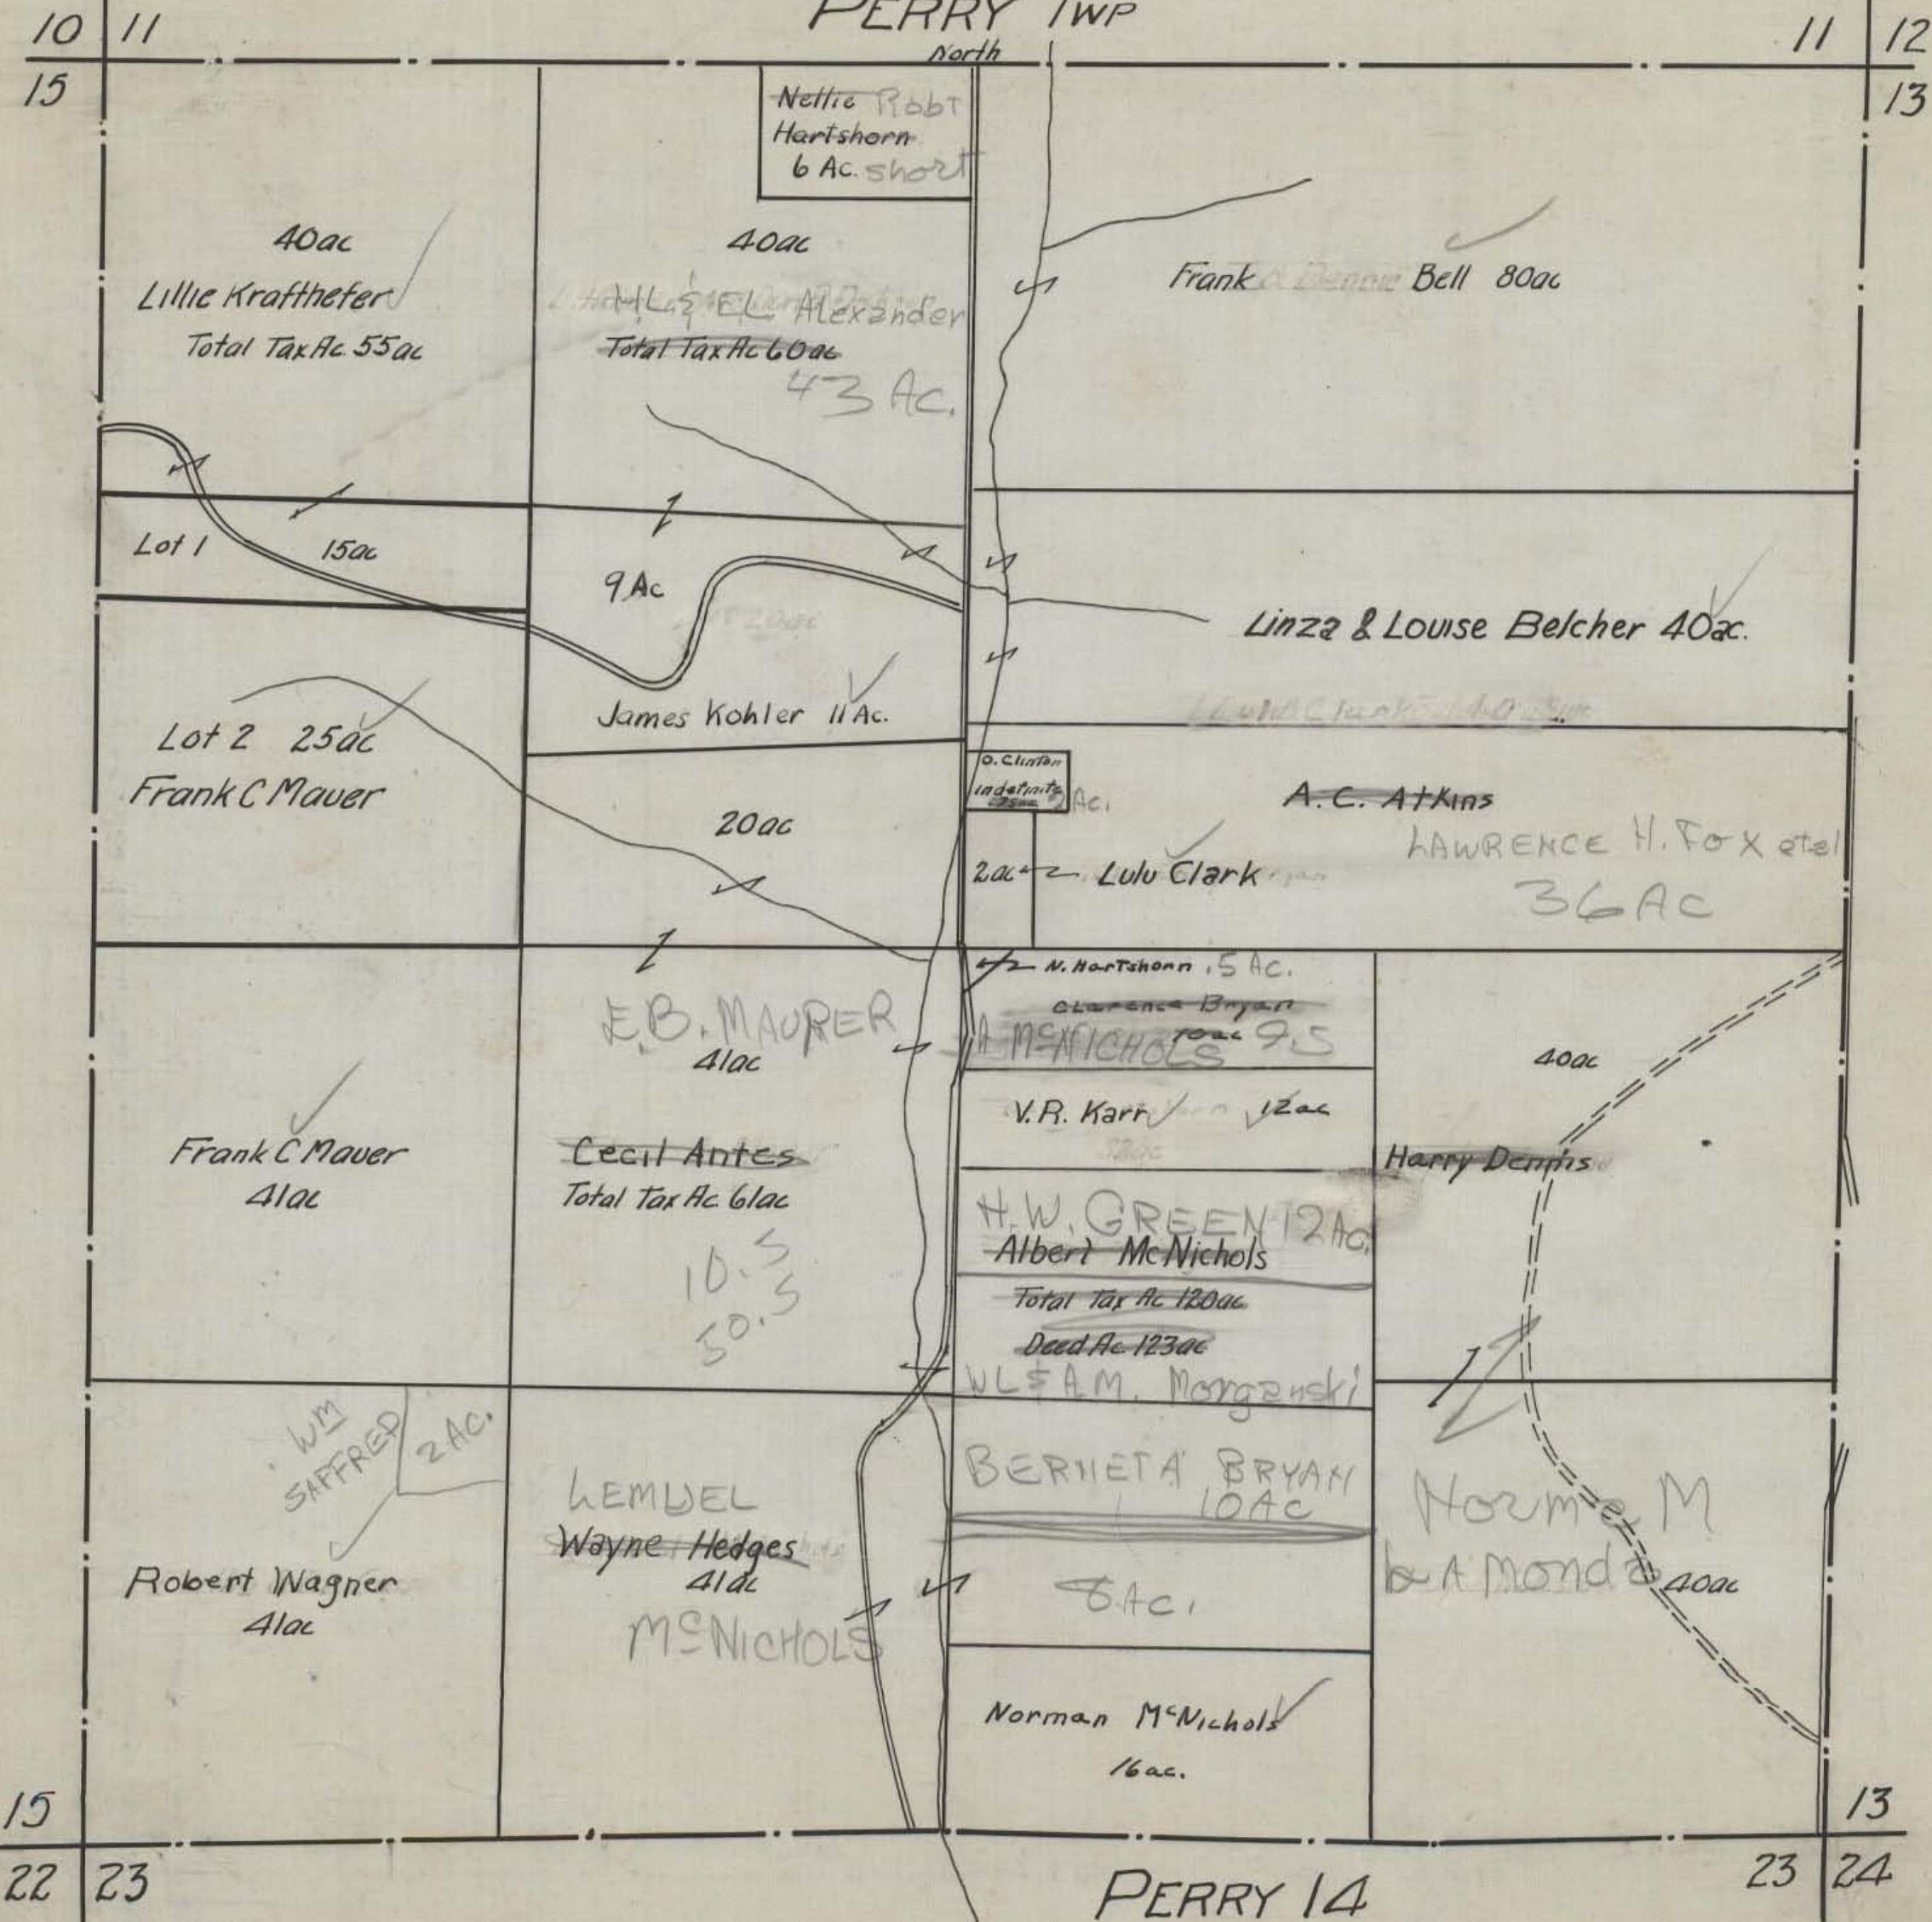

HOCKING COUNTY STATE OF OHIO

Orig 1944 A.W.S.

SEC 15 TWP 12 RANGE 19

PERRY TWP


NORTH



HOCKING COUNTY OHIO


A.W.S. 1945

Sec 16 Twp 12 Range 19
PERRY TWP

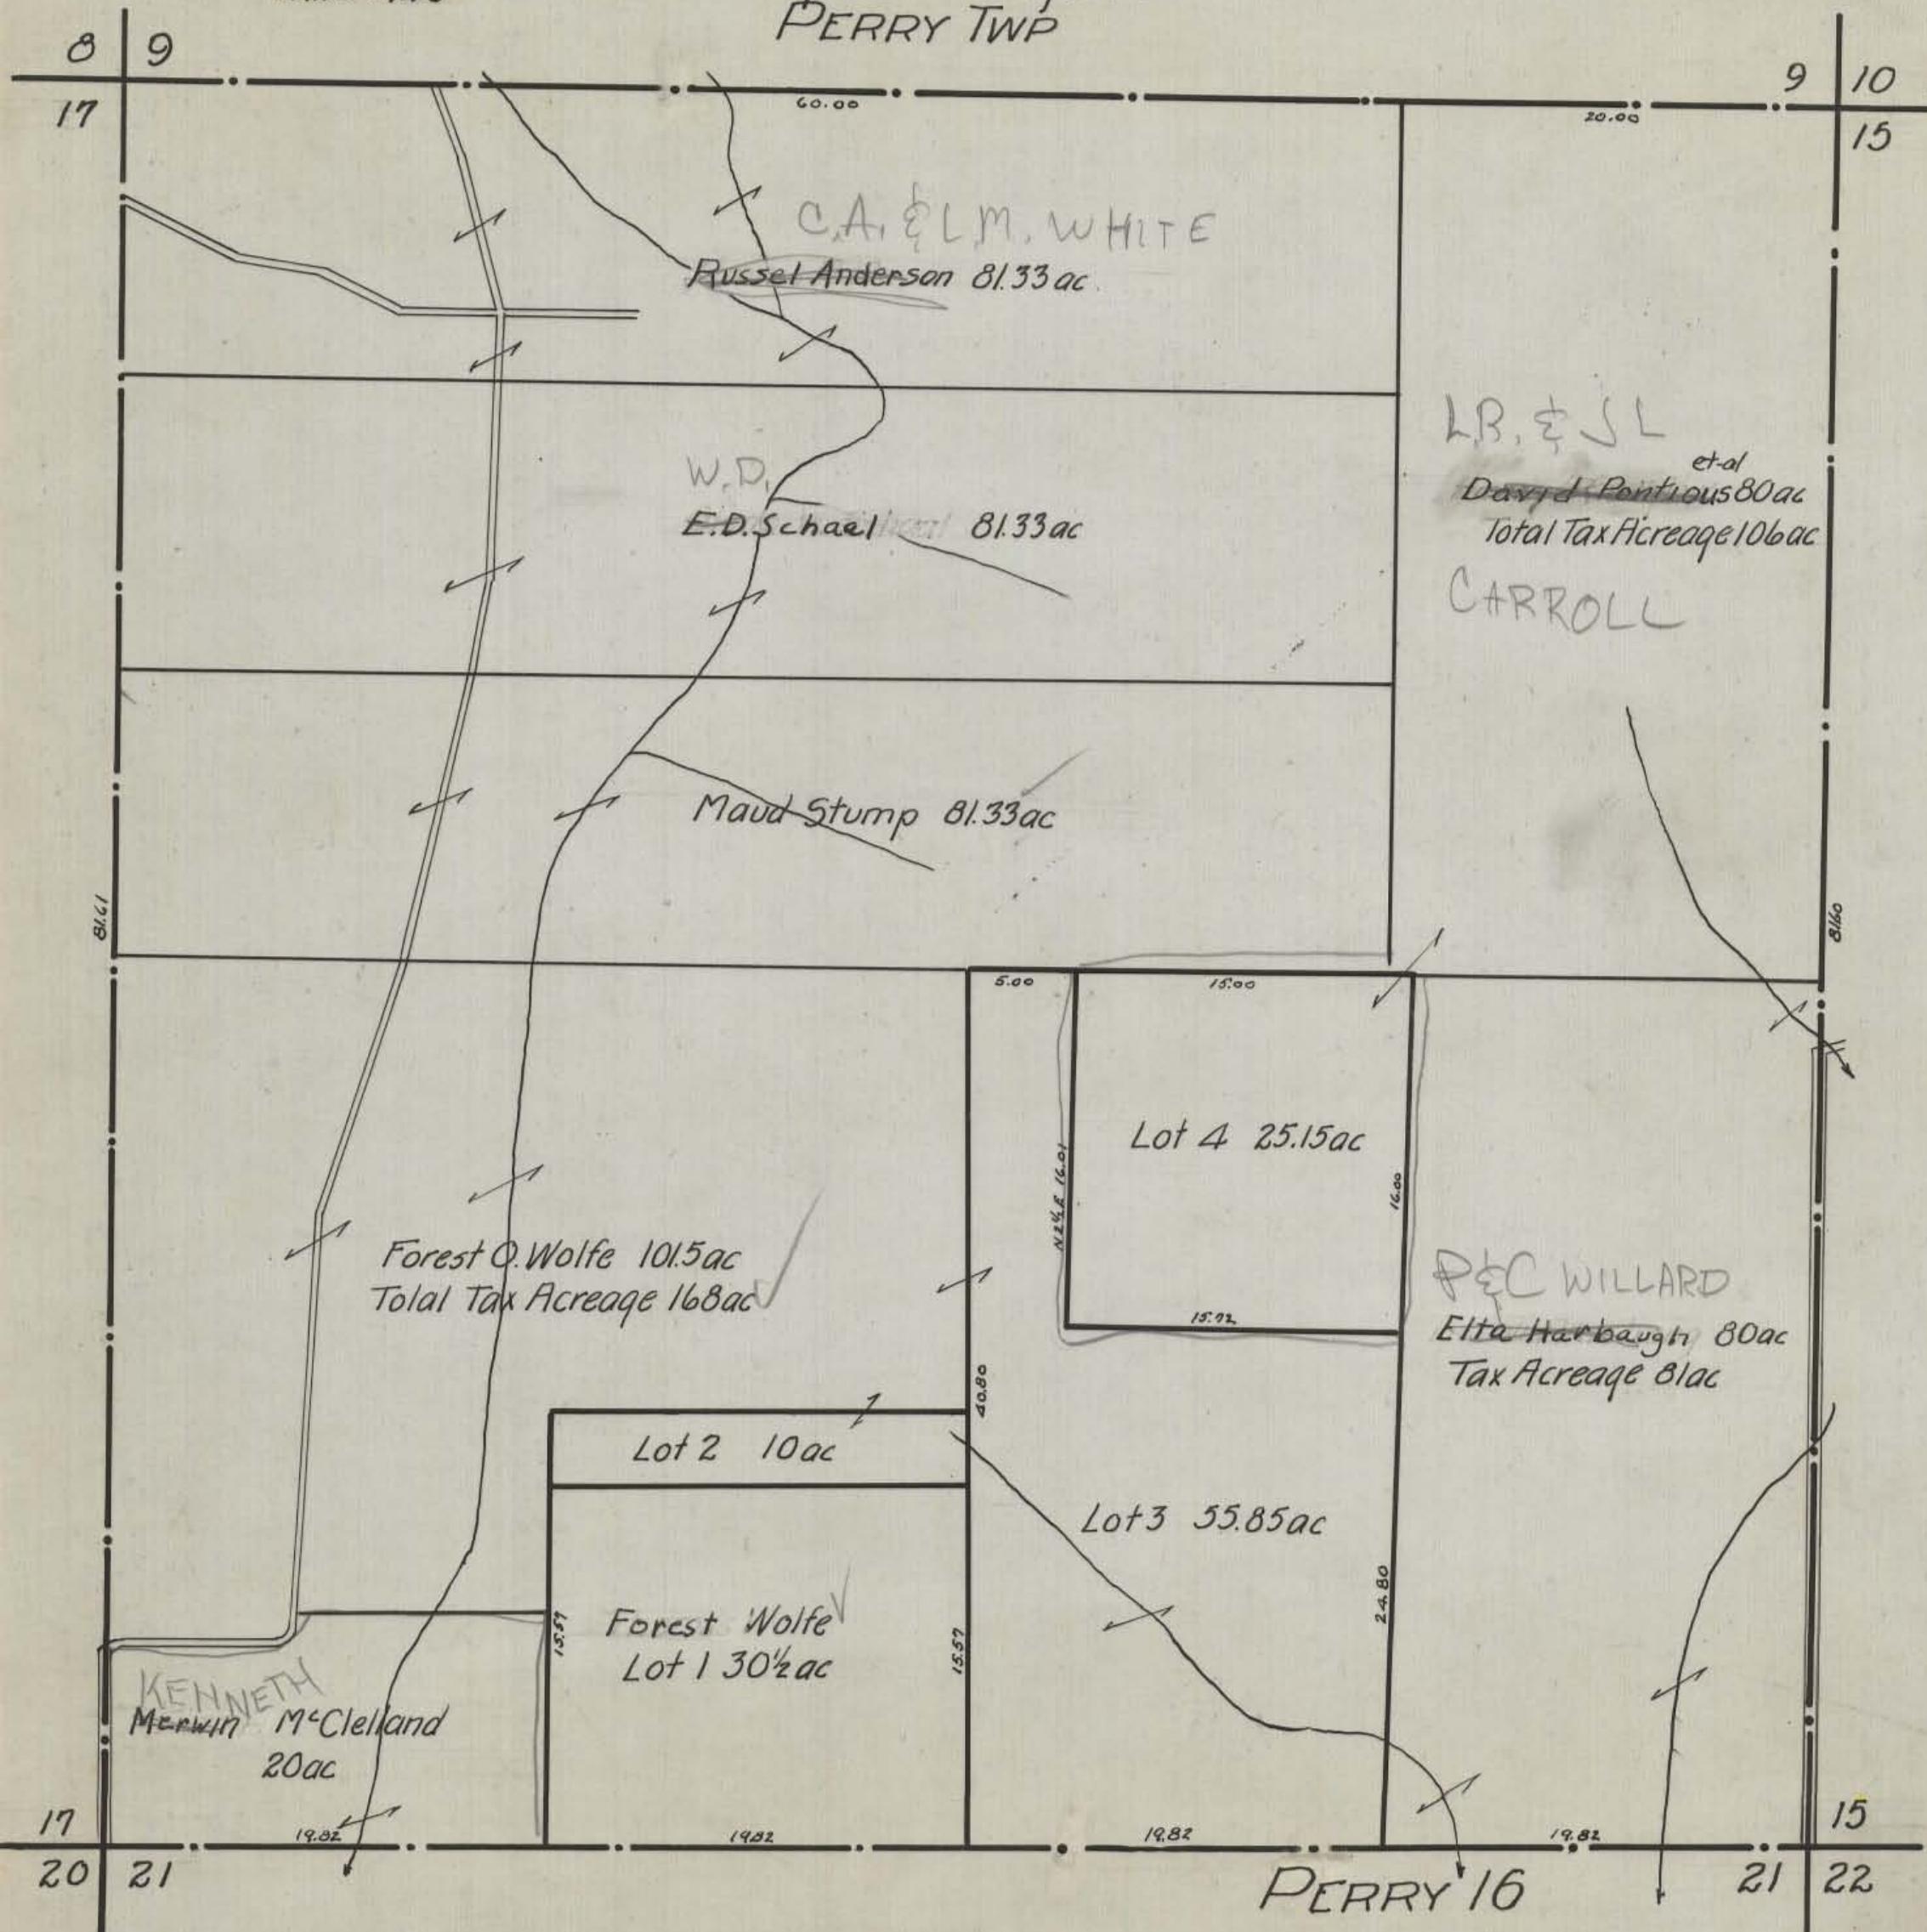

HOCKING COUNTY STATE OHIO
Sec. 17 Twp. 12 Range 19
PERRY TWP

A.W.S 1945

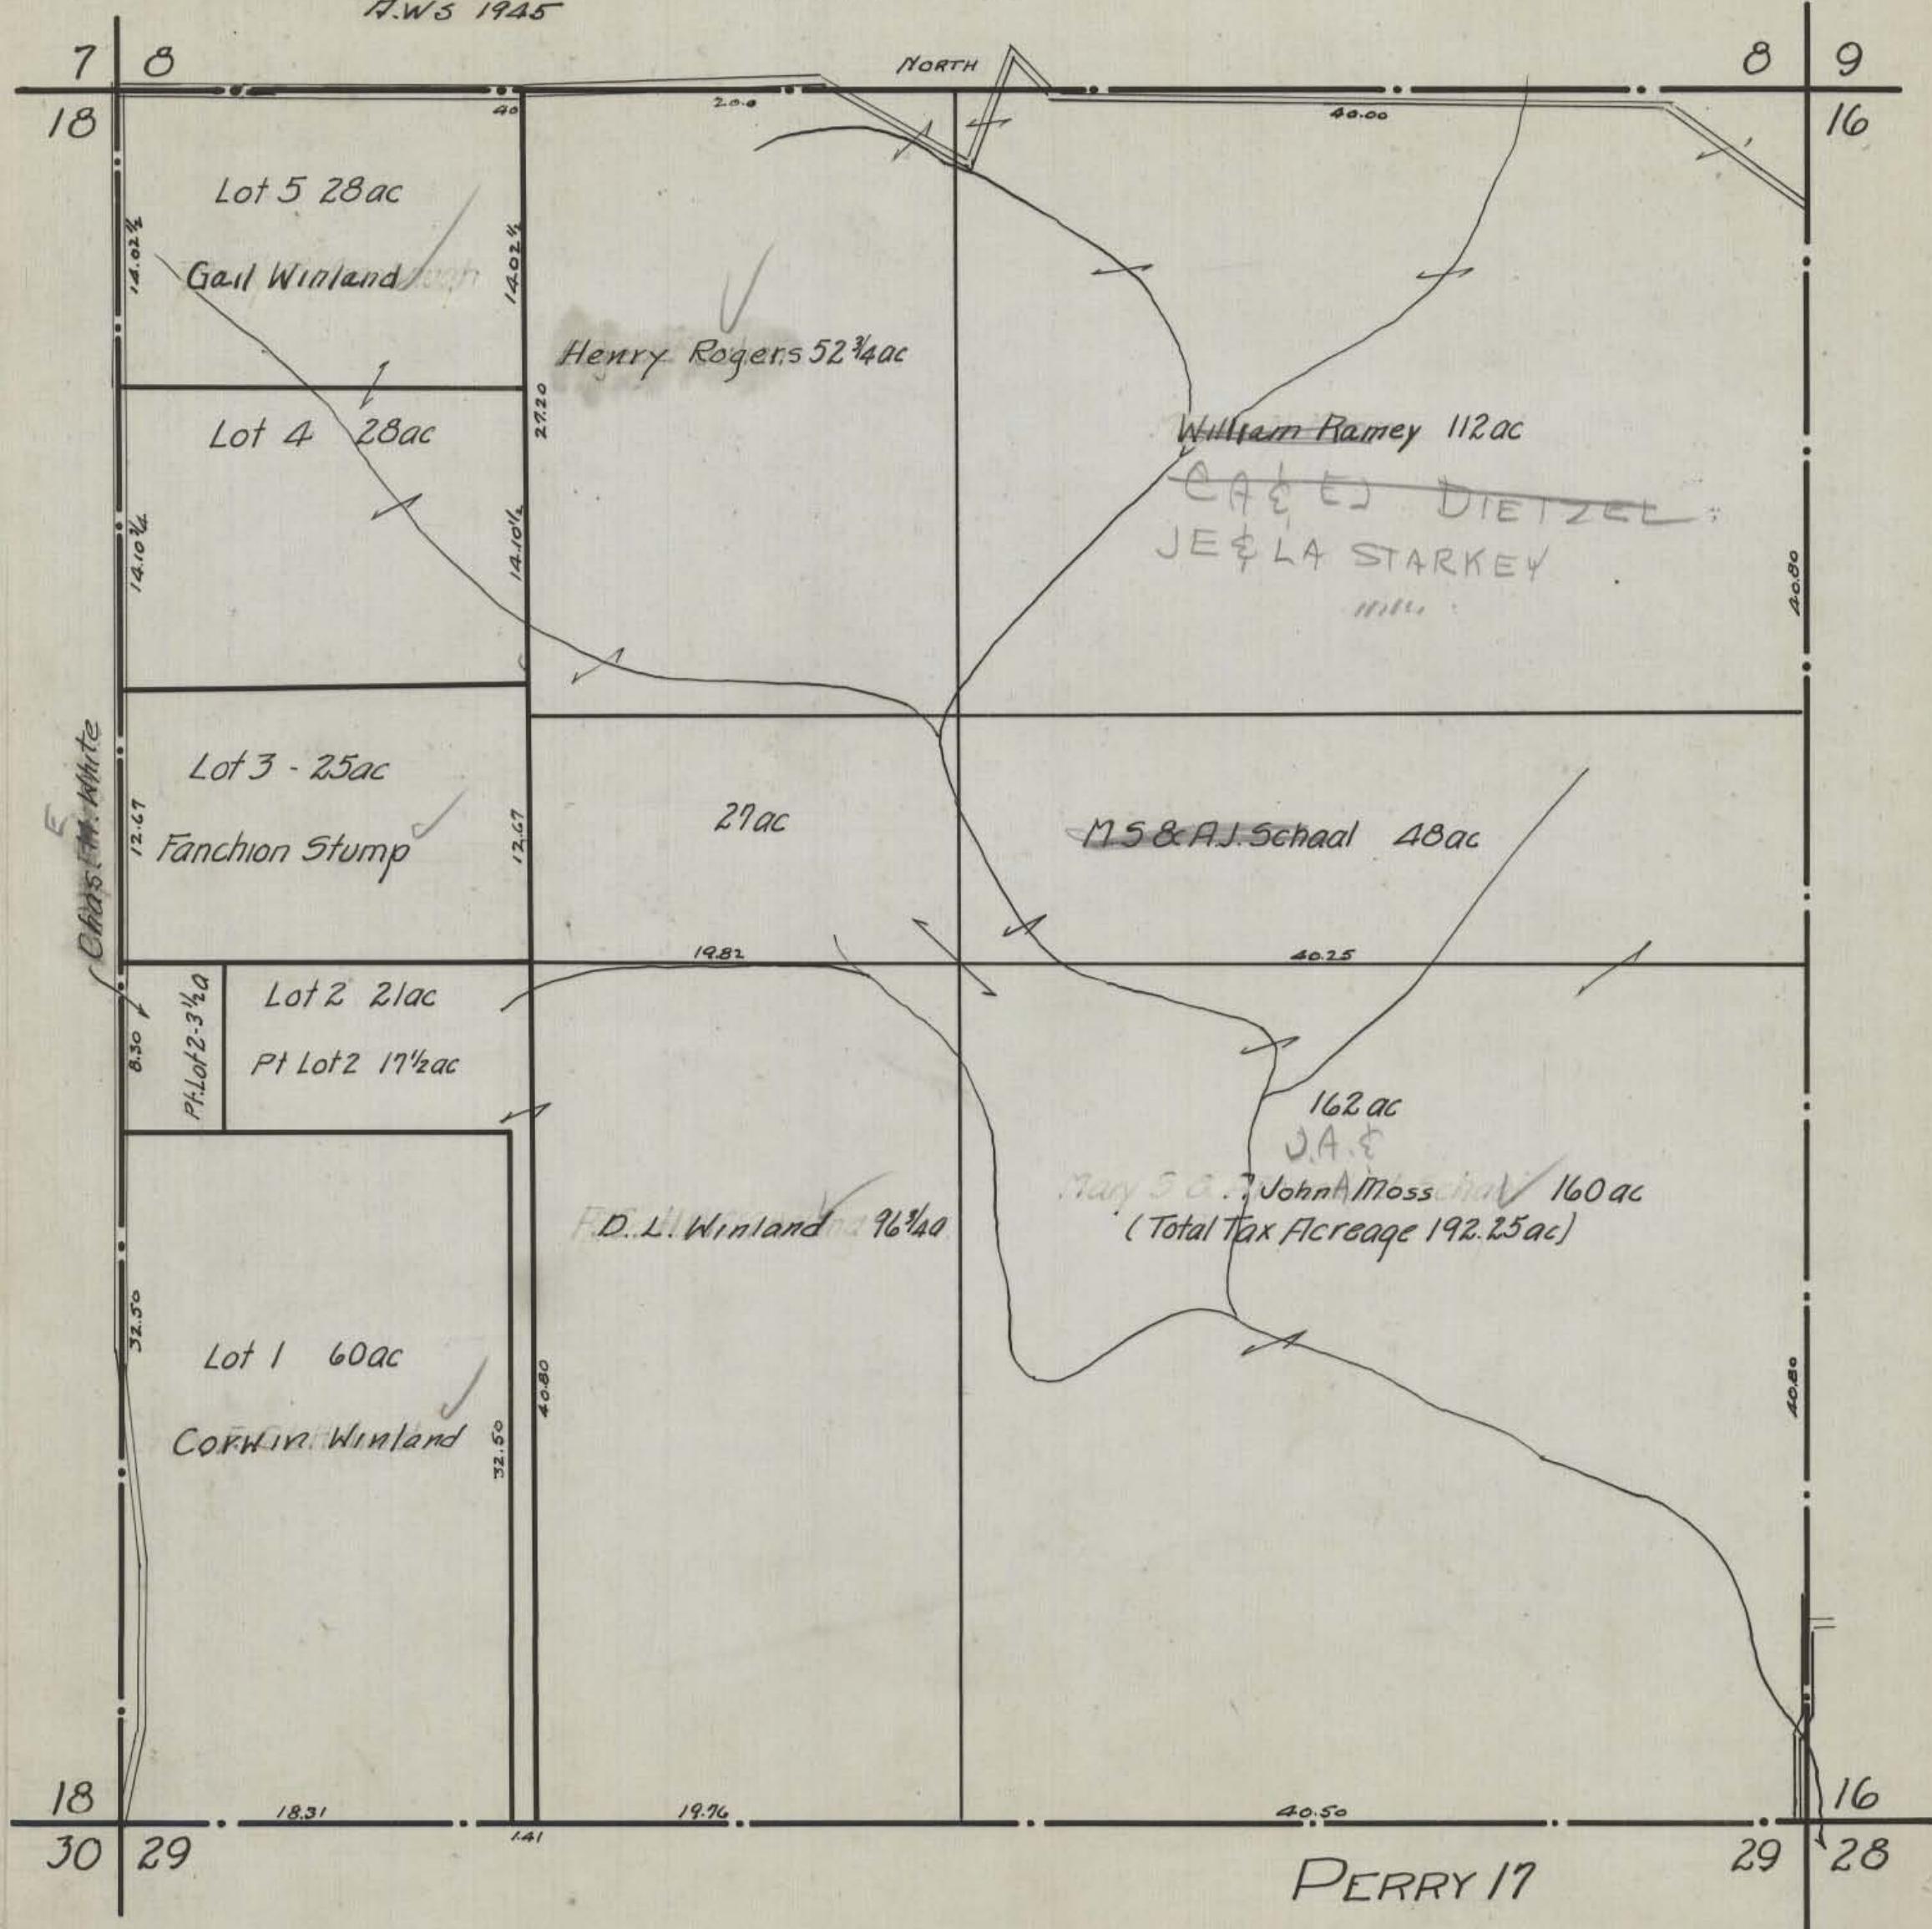


HOCKING COUNTY STATE OHIO

Sec 18 Twp 12 Range 19

PERRY TWP

A.W.S. 1945

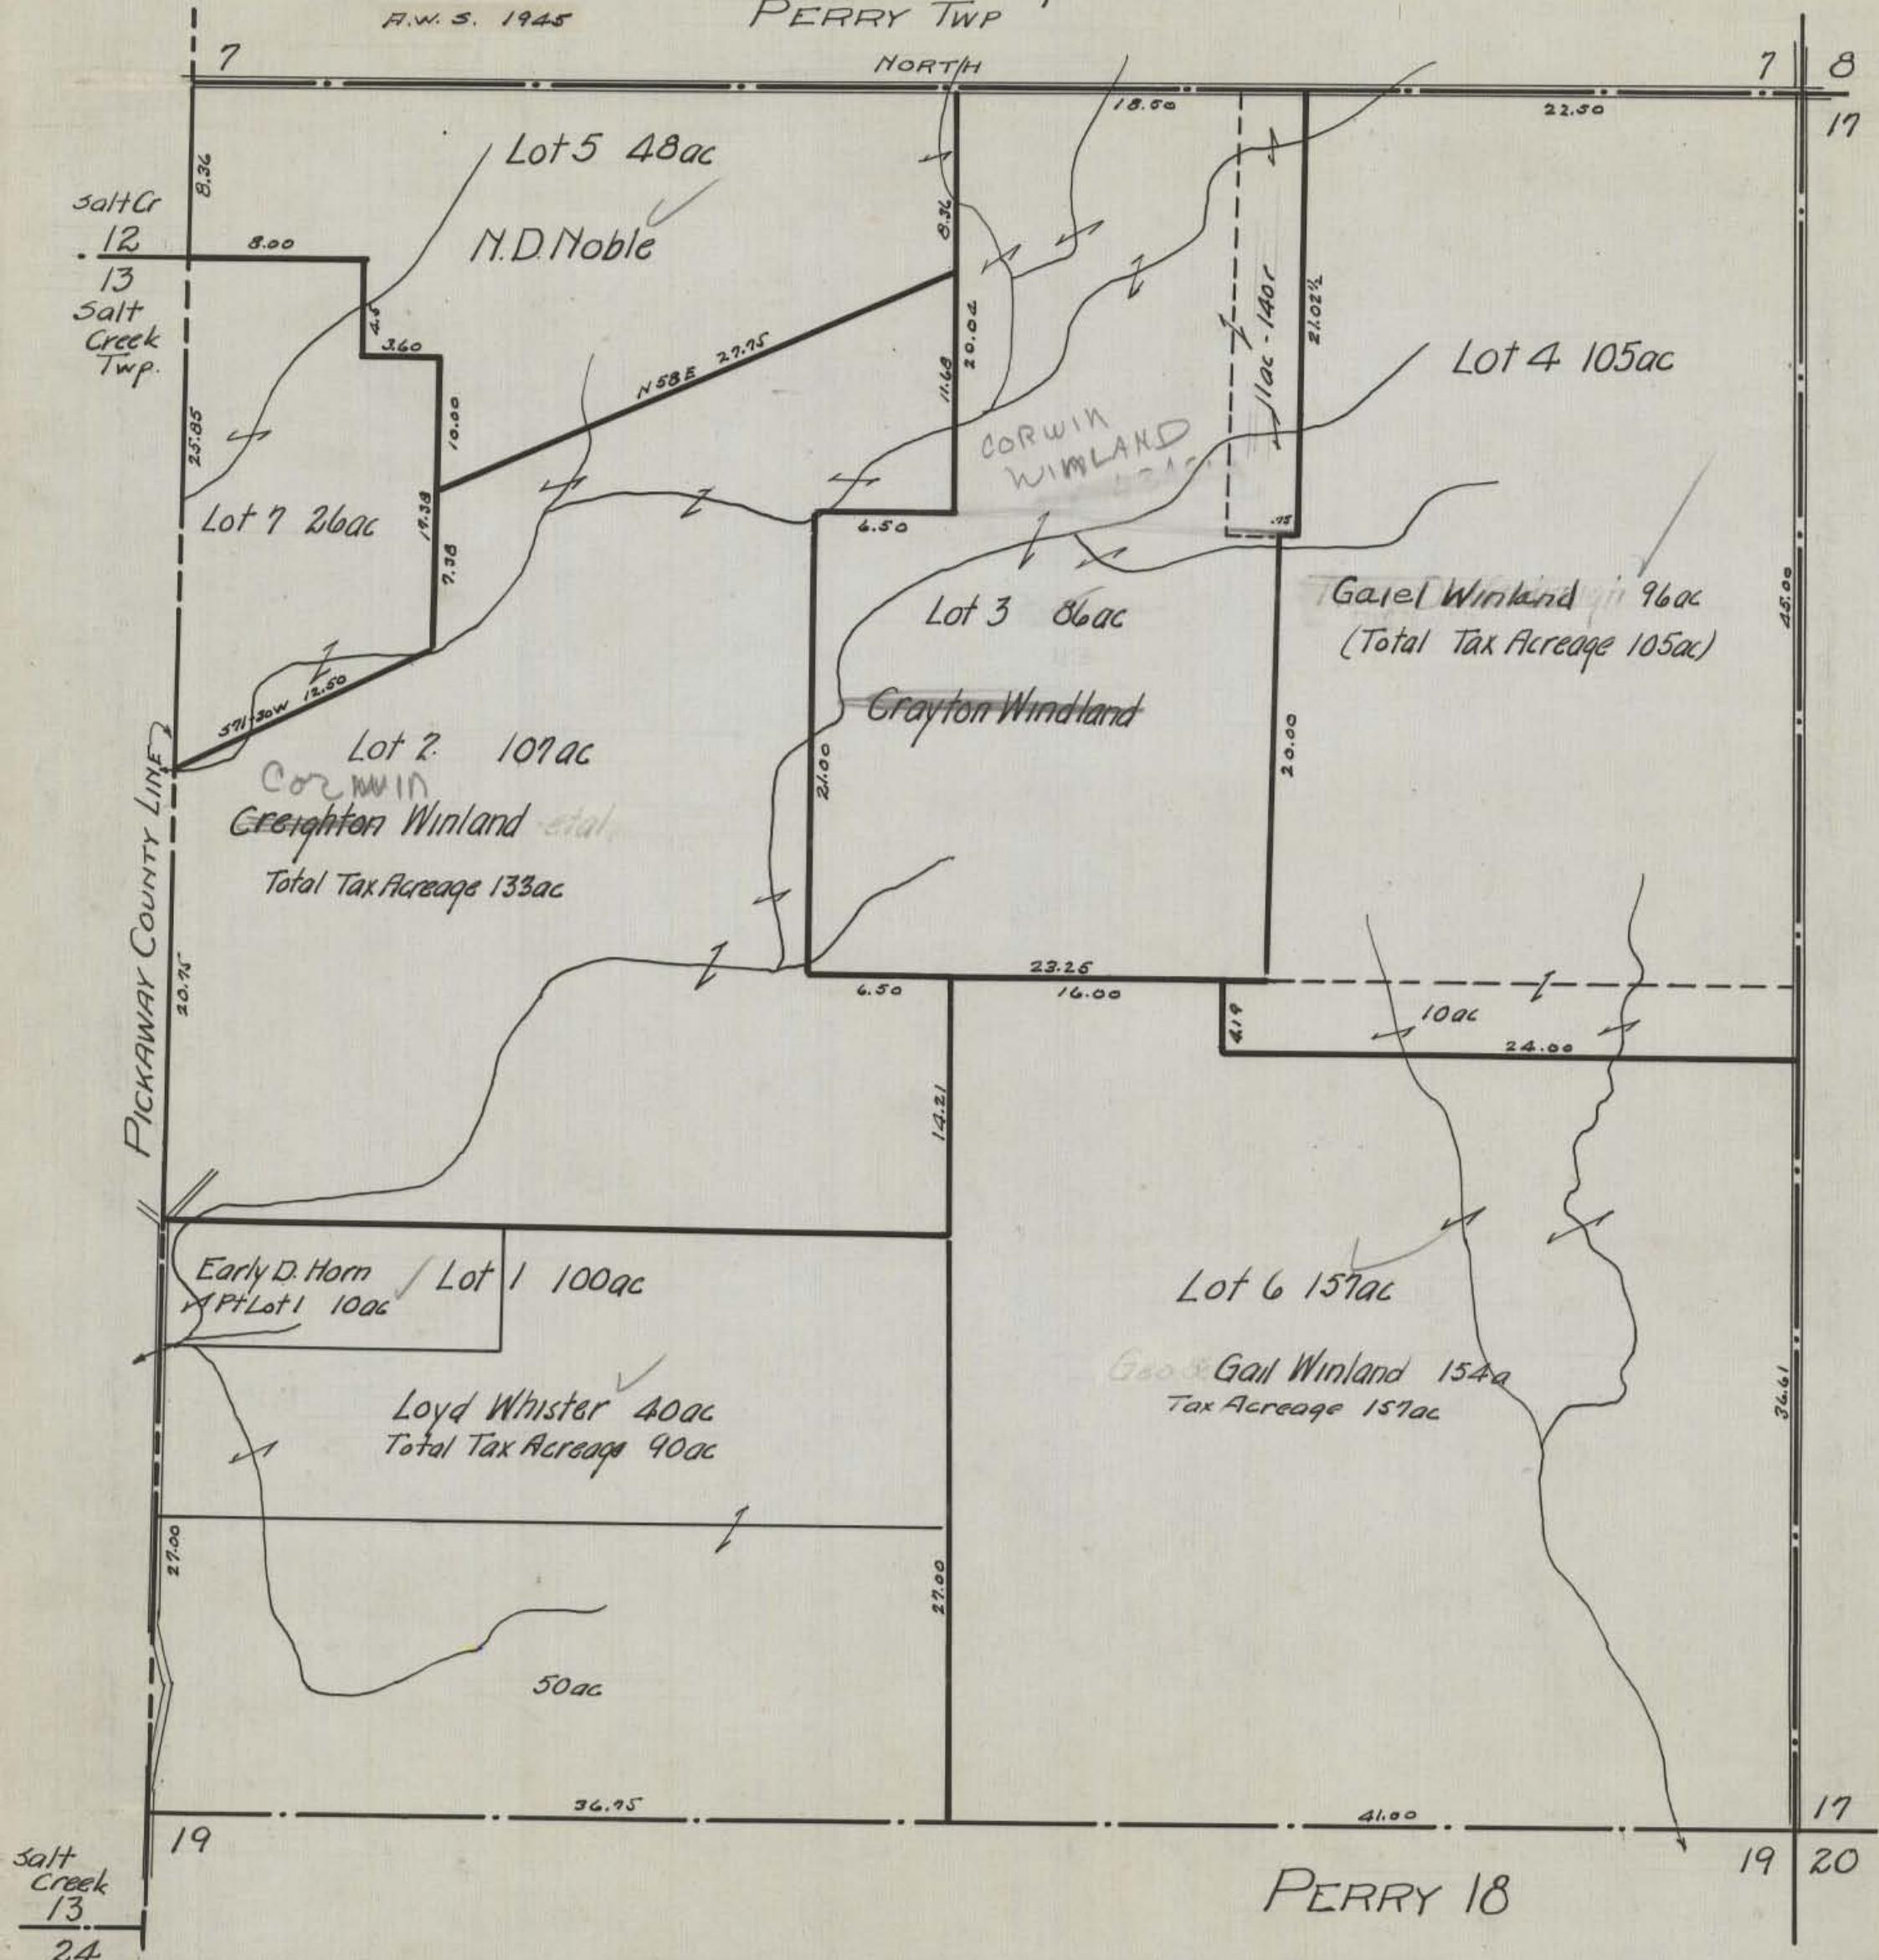

HOCKING COUNTY STATE OHIO

Sec 19 TWP 12 Range 19

PERRY TWP

A.W.S. 1945




HOCKING COUNTY STATE OHIO

A.W.S Dec 1944


Sec 20 Twp 12 Range 19
PERRY TWP.

North

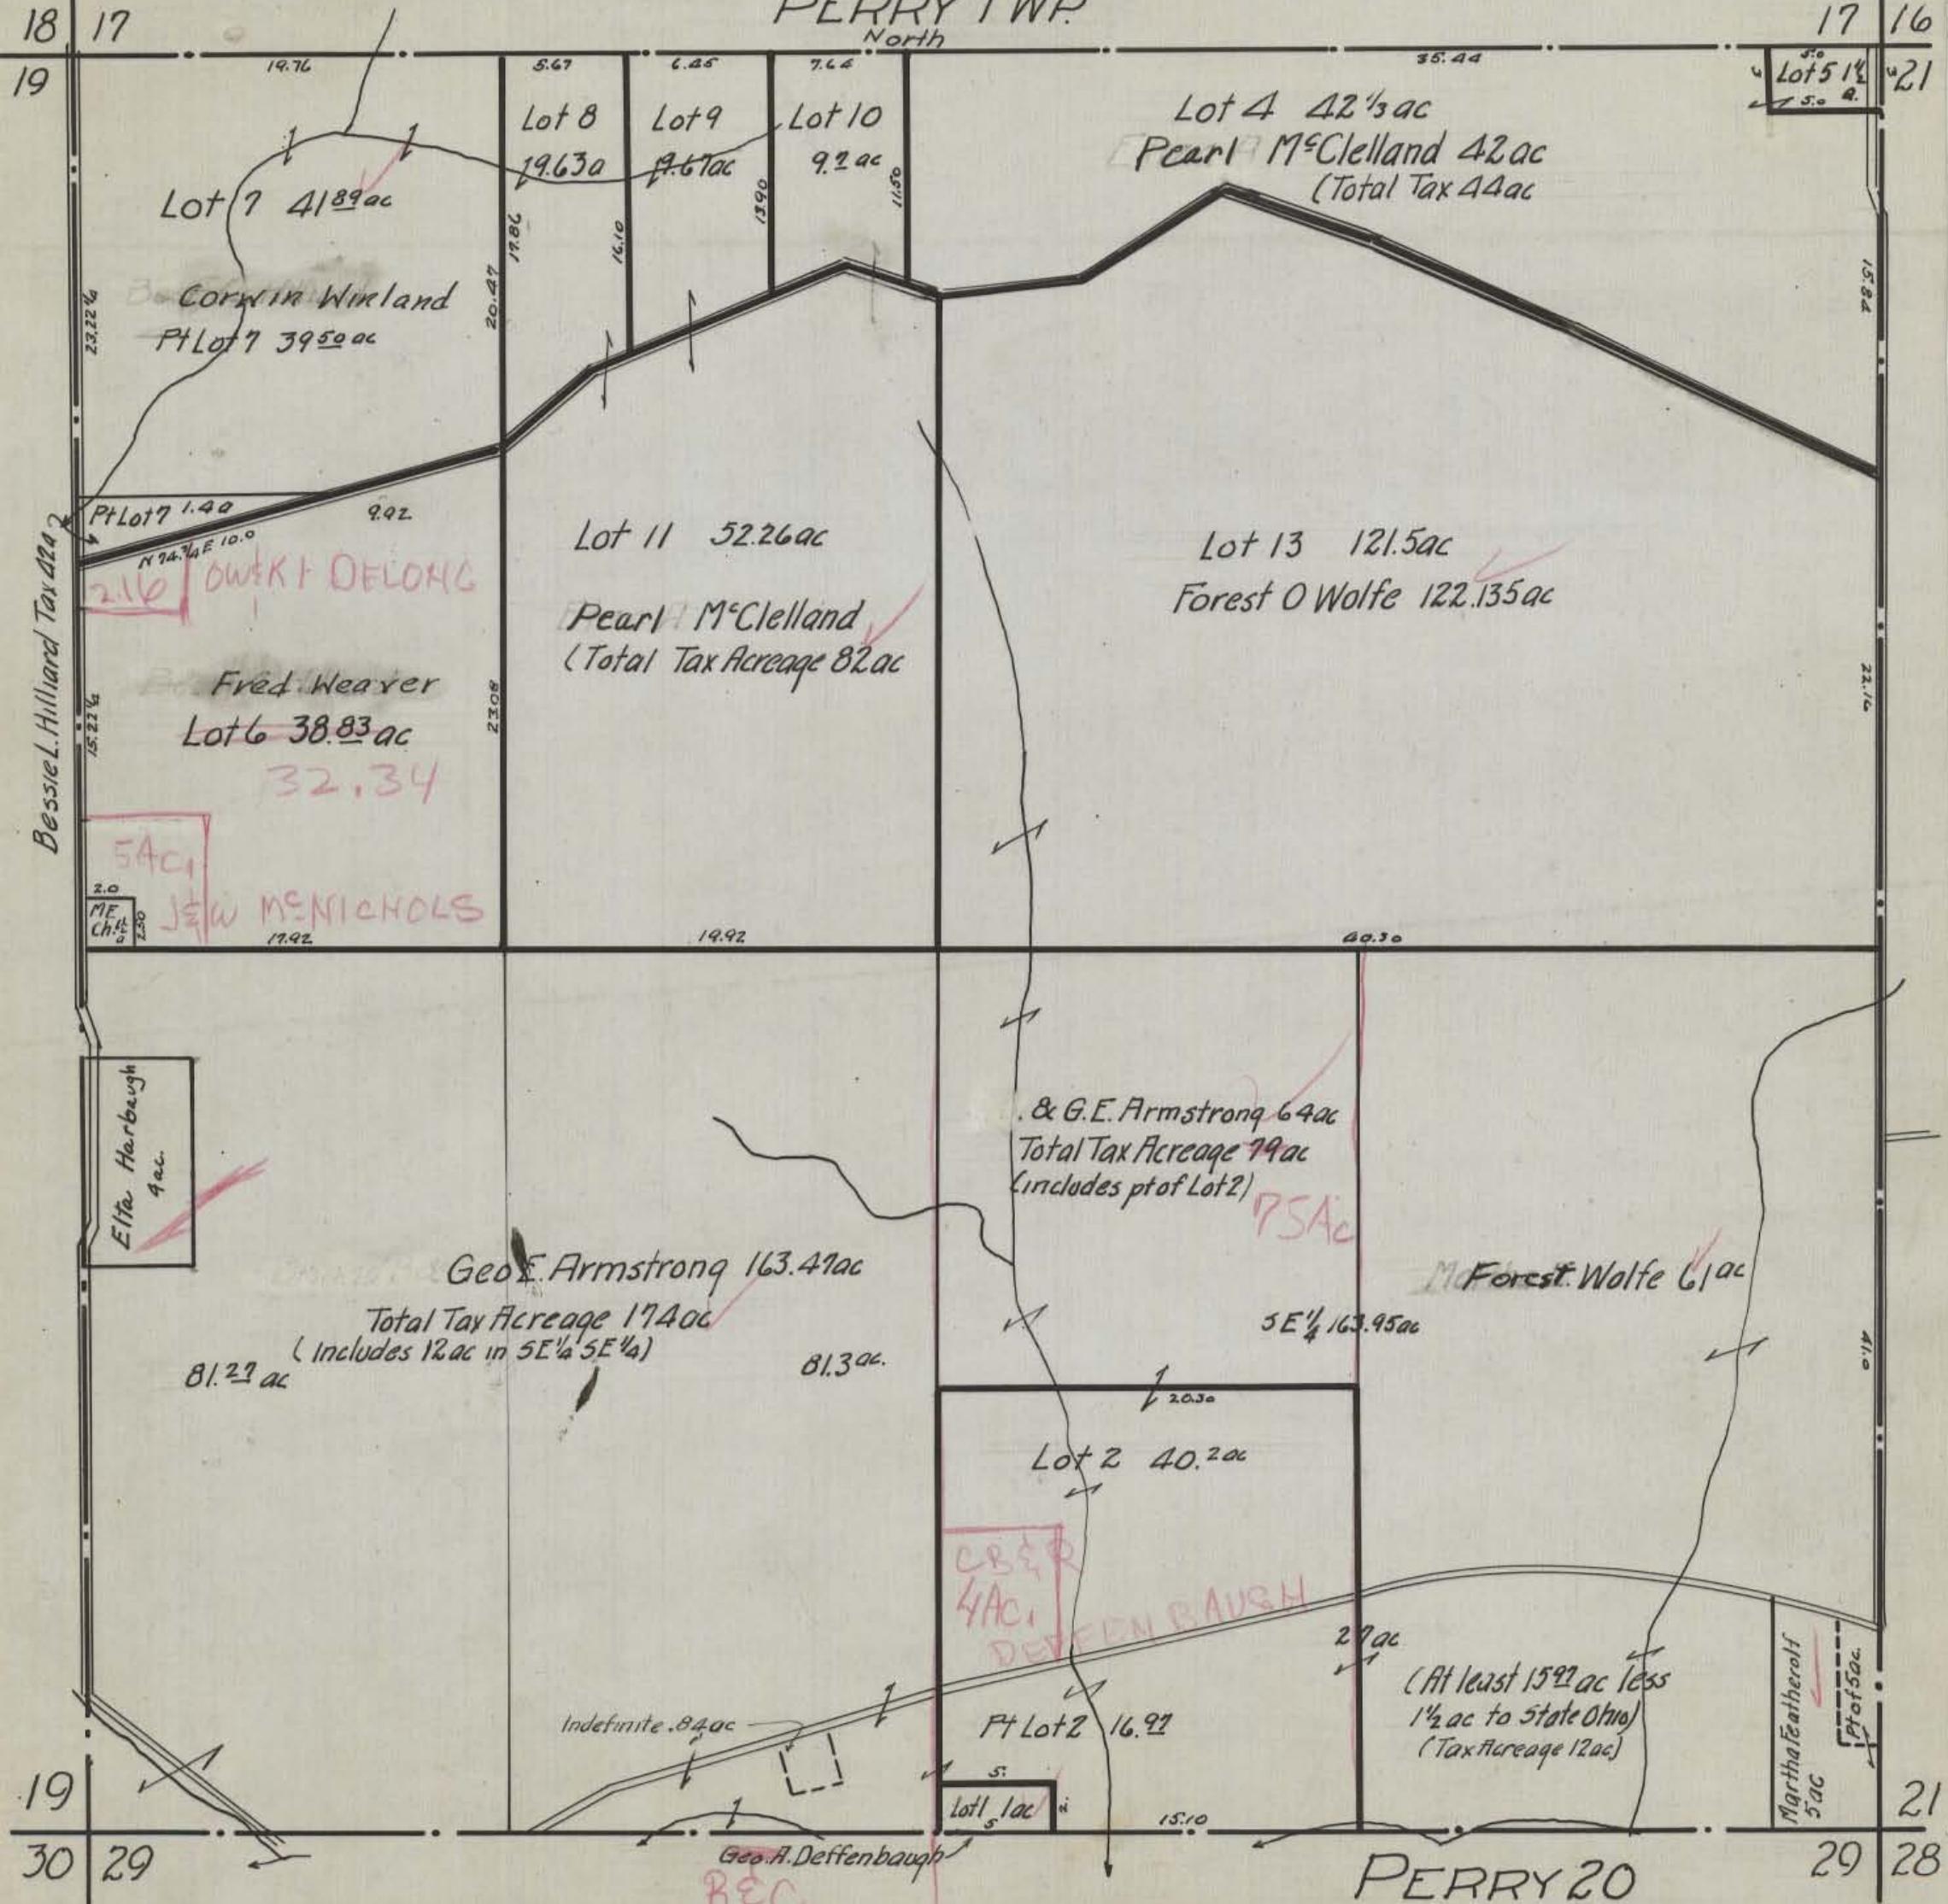

Hocking County State Ohio

Sec 21 Twp 12 Range 19
PERRY TWP

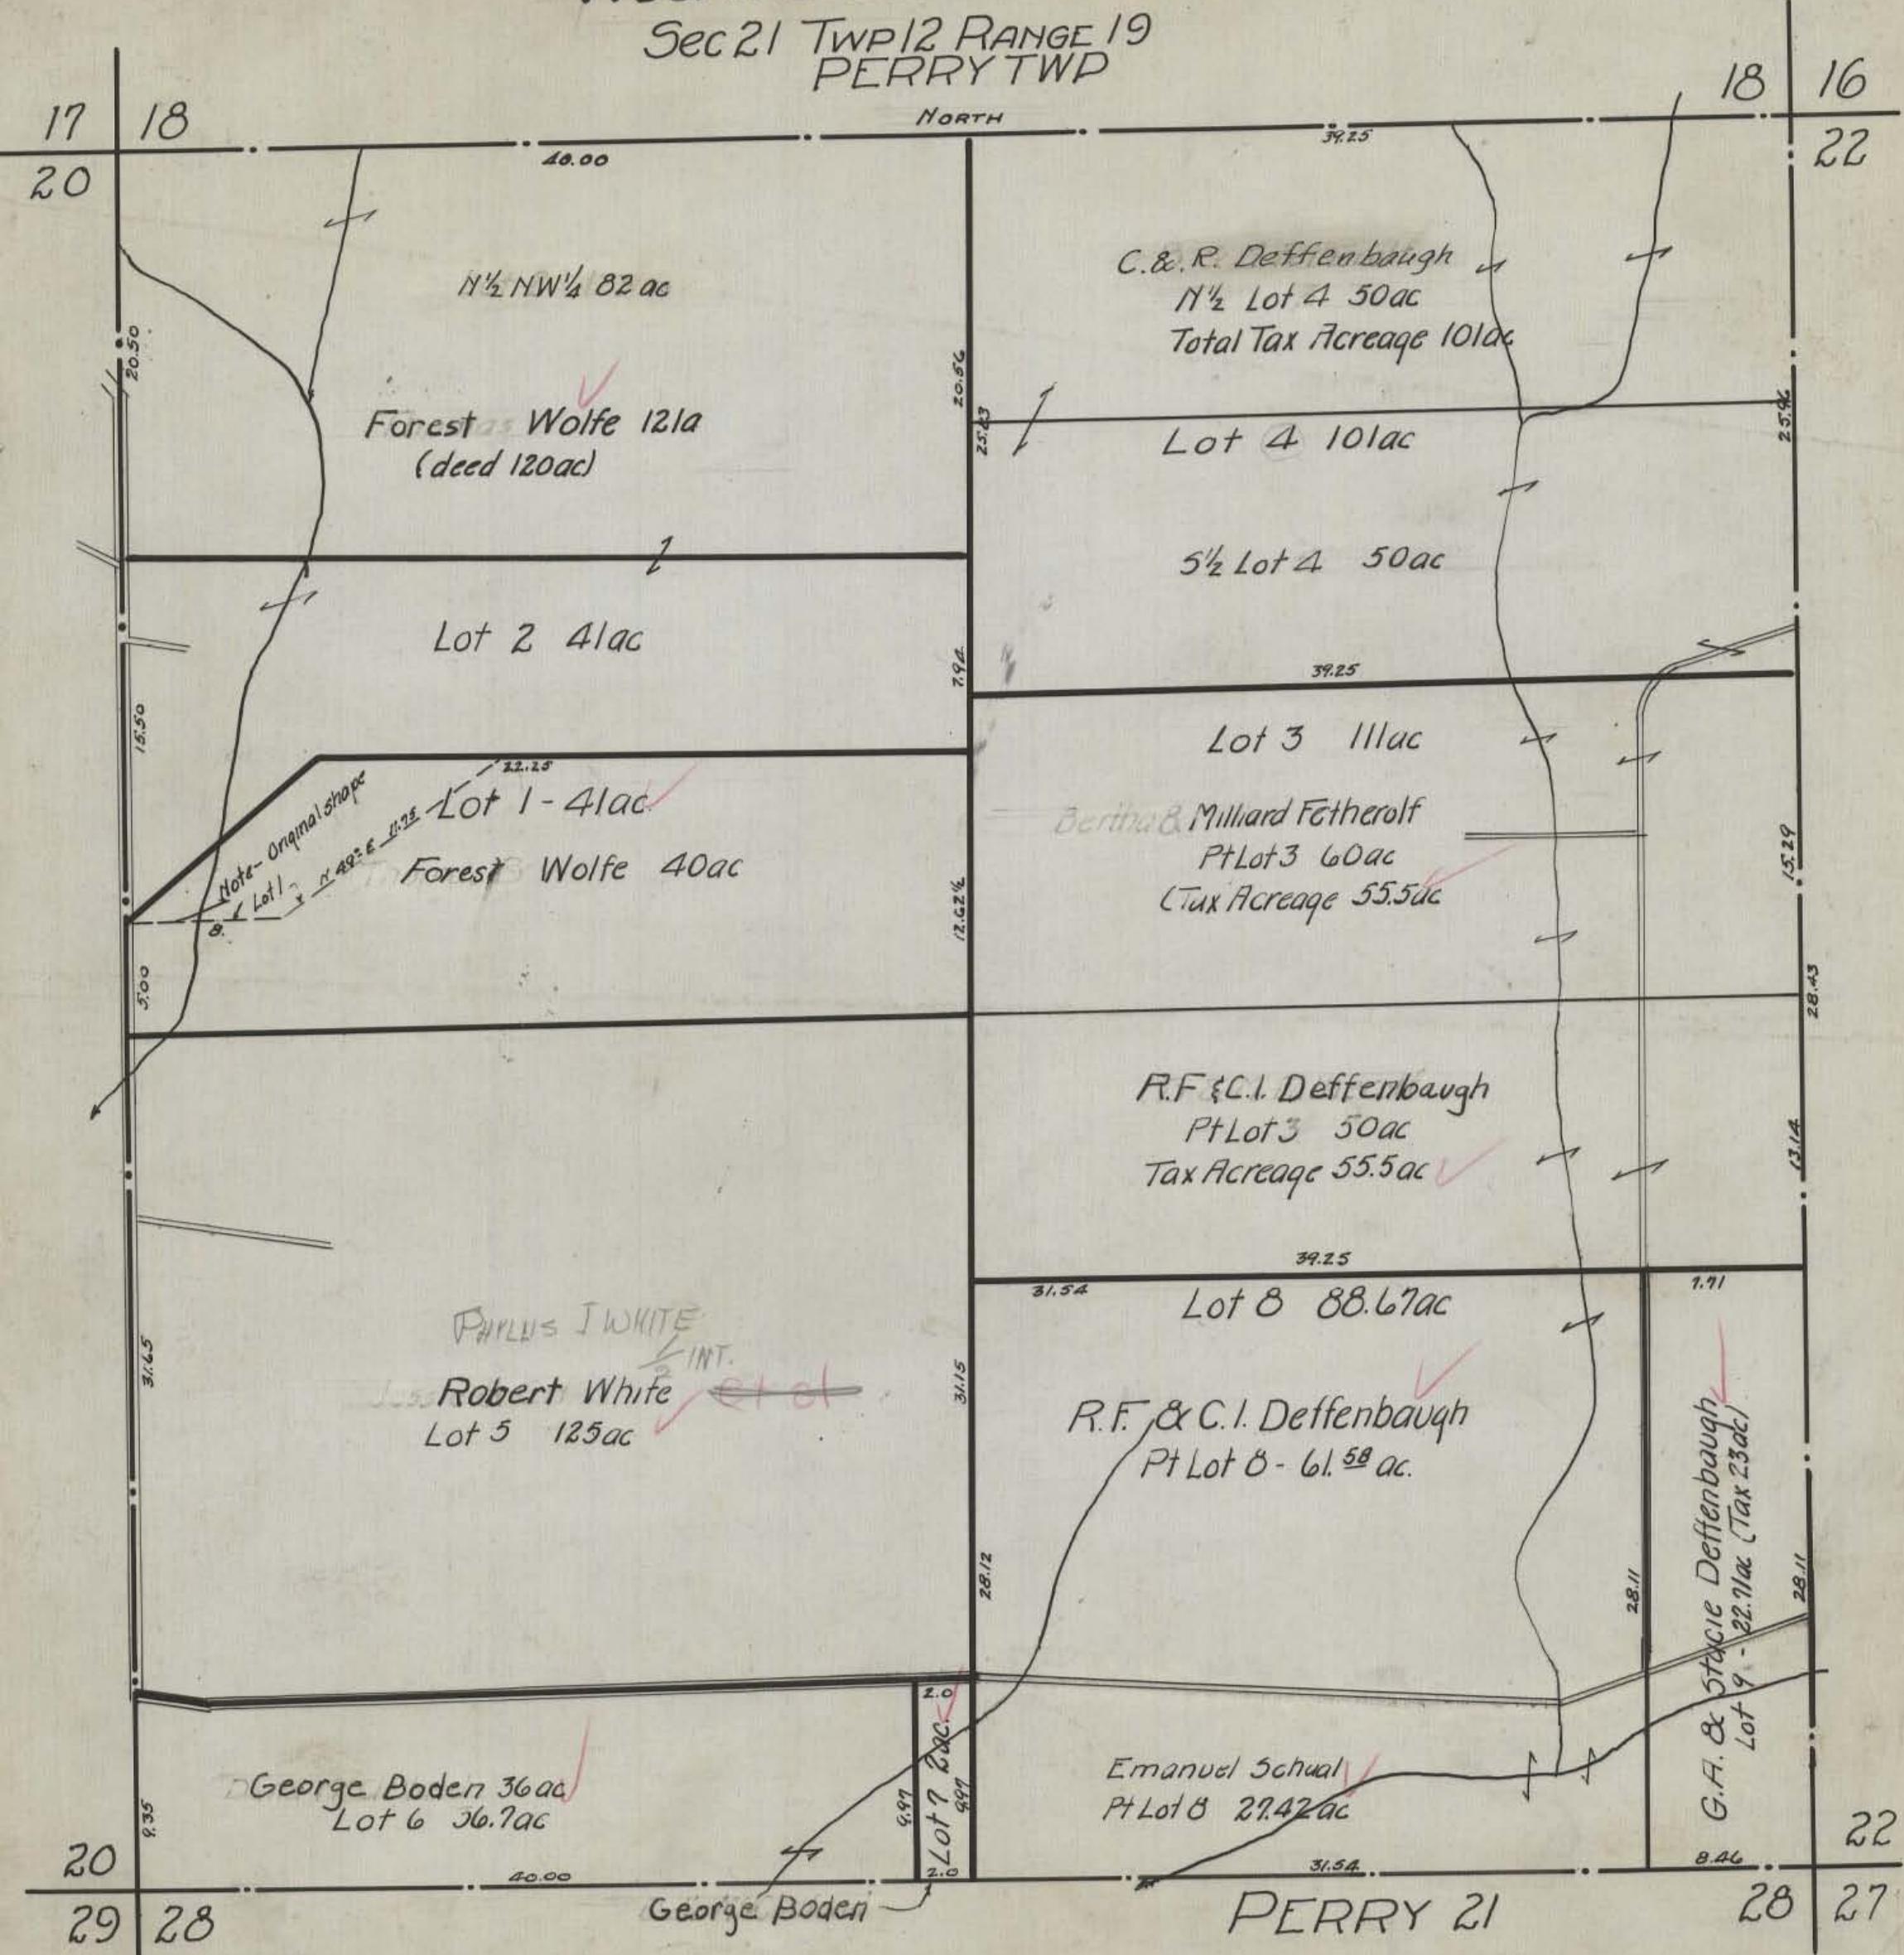


HOCKING COUNTY STATE OHIO

Sec 22 Twp 12N; Range 19 W.

A.W.S. 1945 Feb.

PERRY TWP.

NORTH

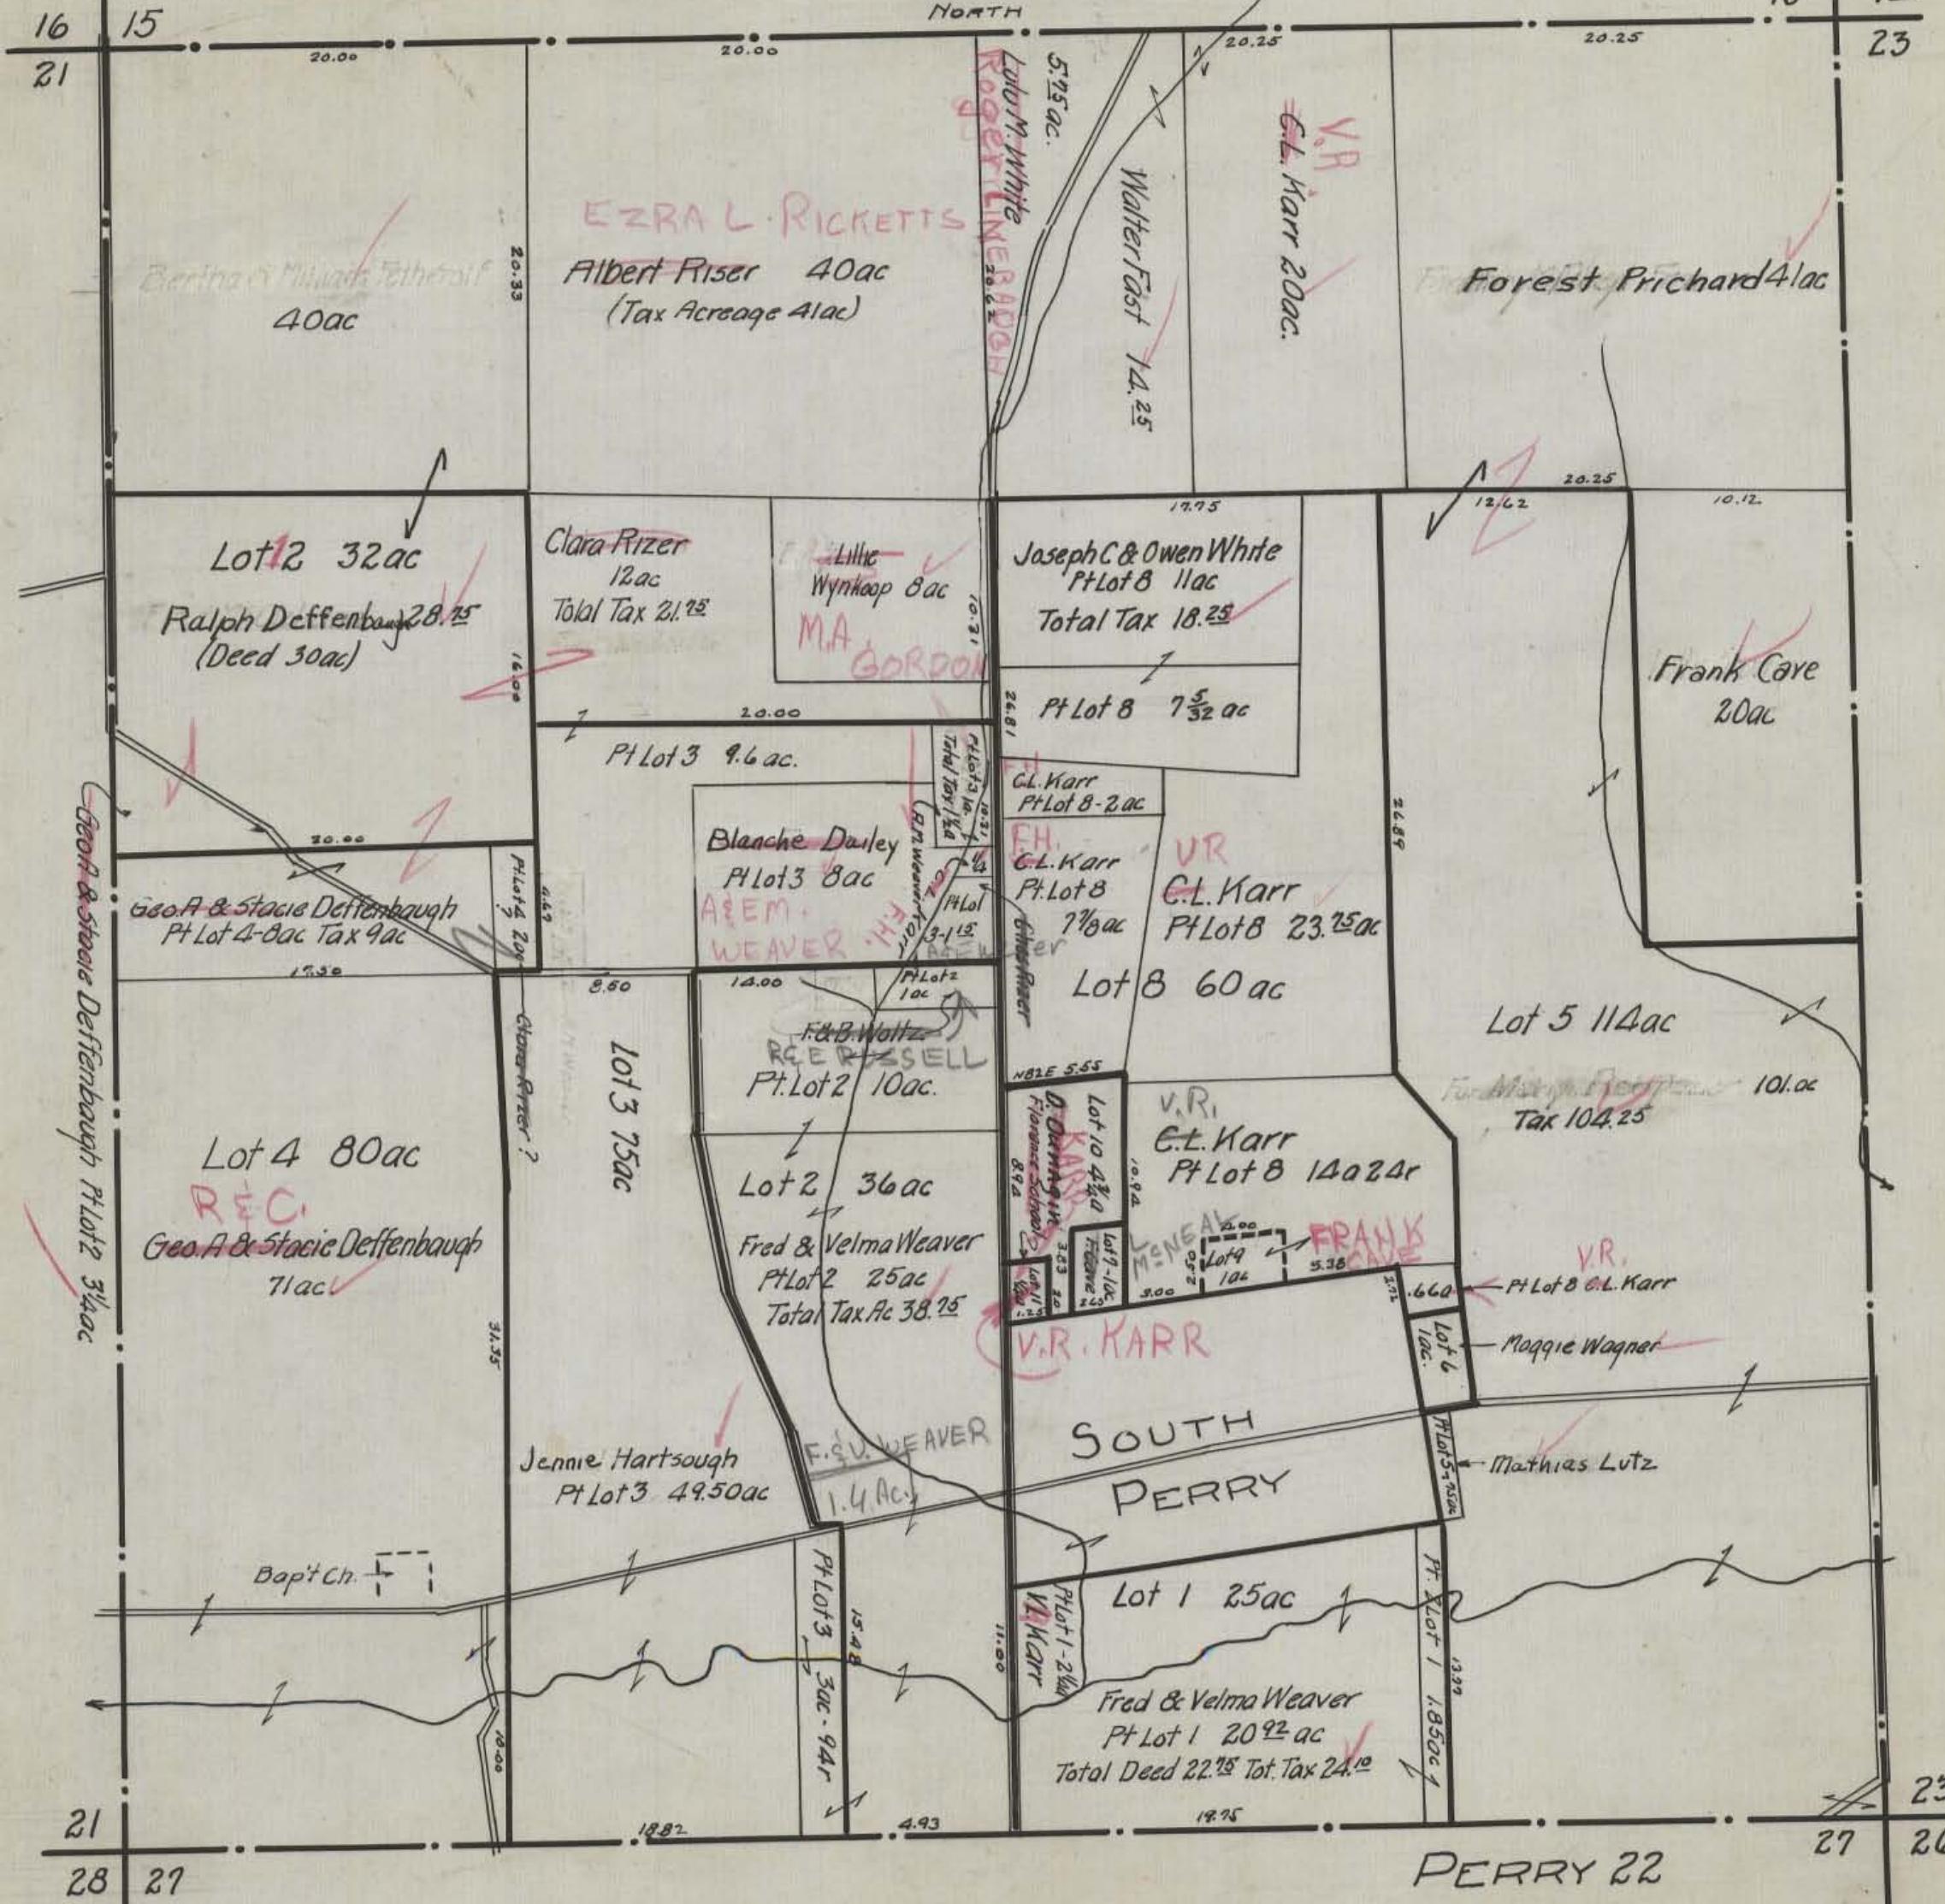


HOCKING COUNTY STATE OHIO


SEC. 23 Twp 12 Range 19

PERRY TWP

North

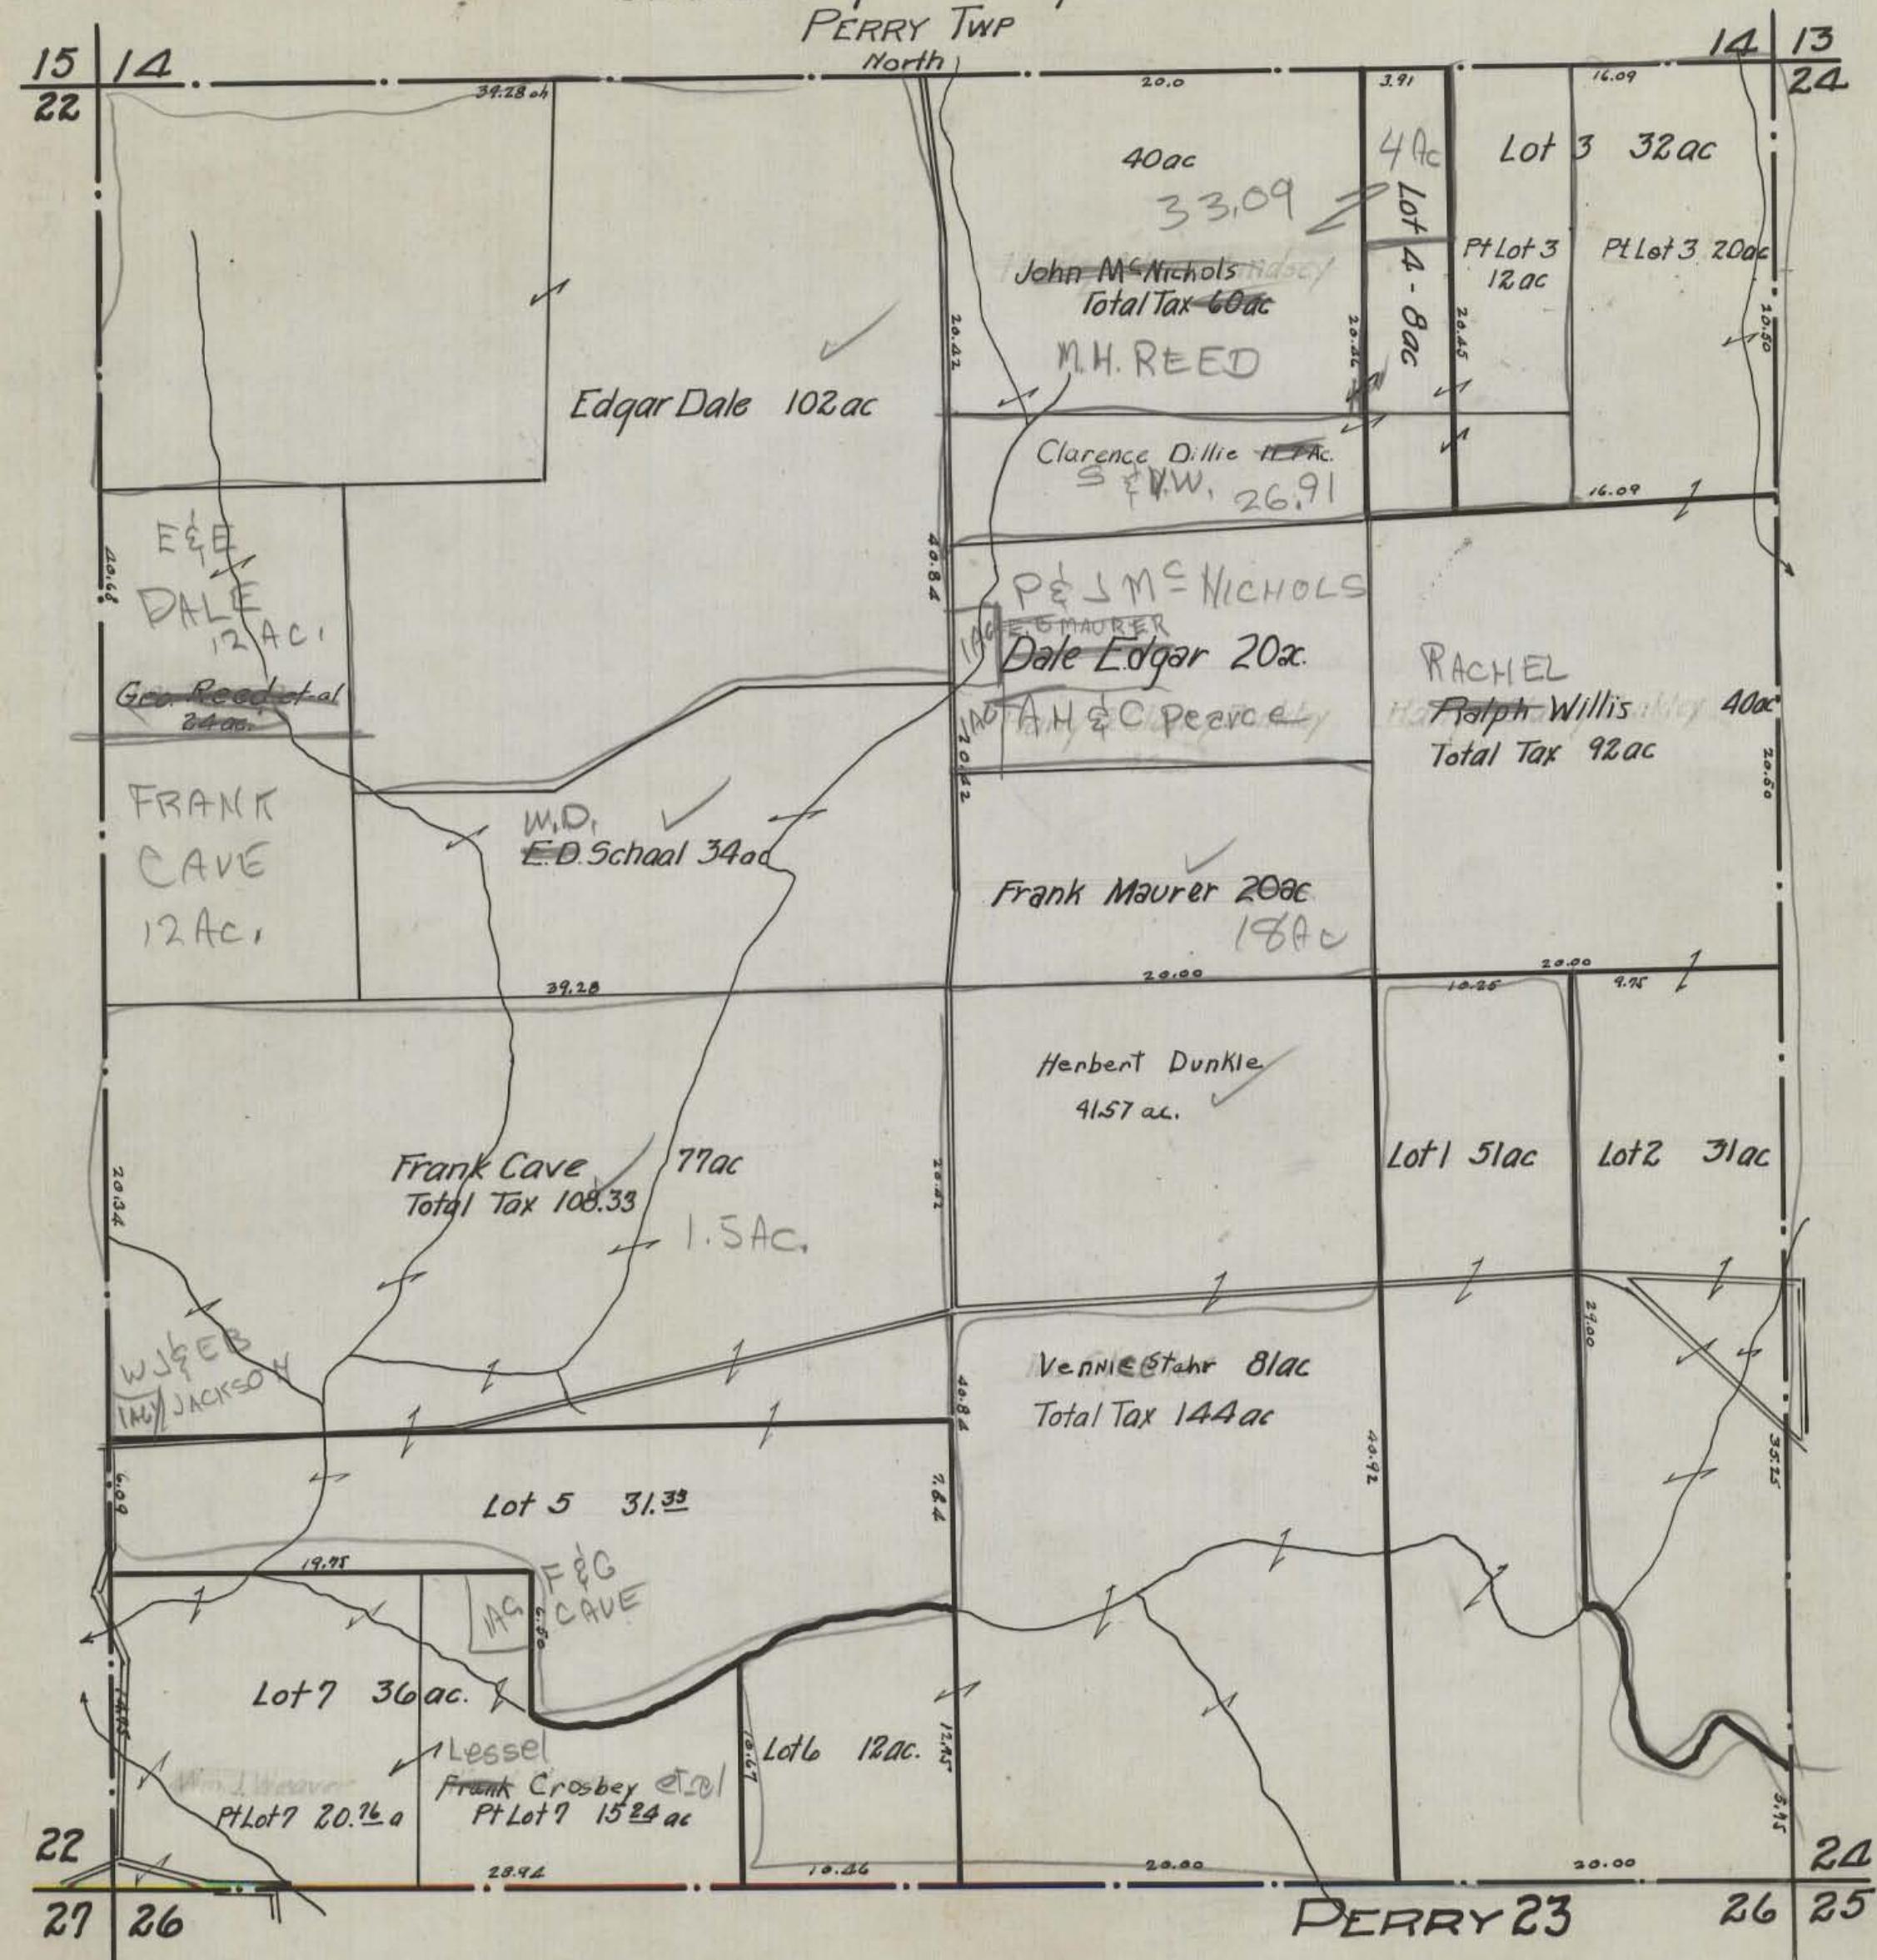

HOCKING COUNTY OHIO
PERRY TWP.
Sec 24 Twp 12. Range 19

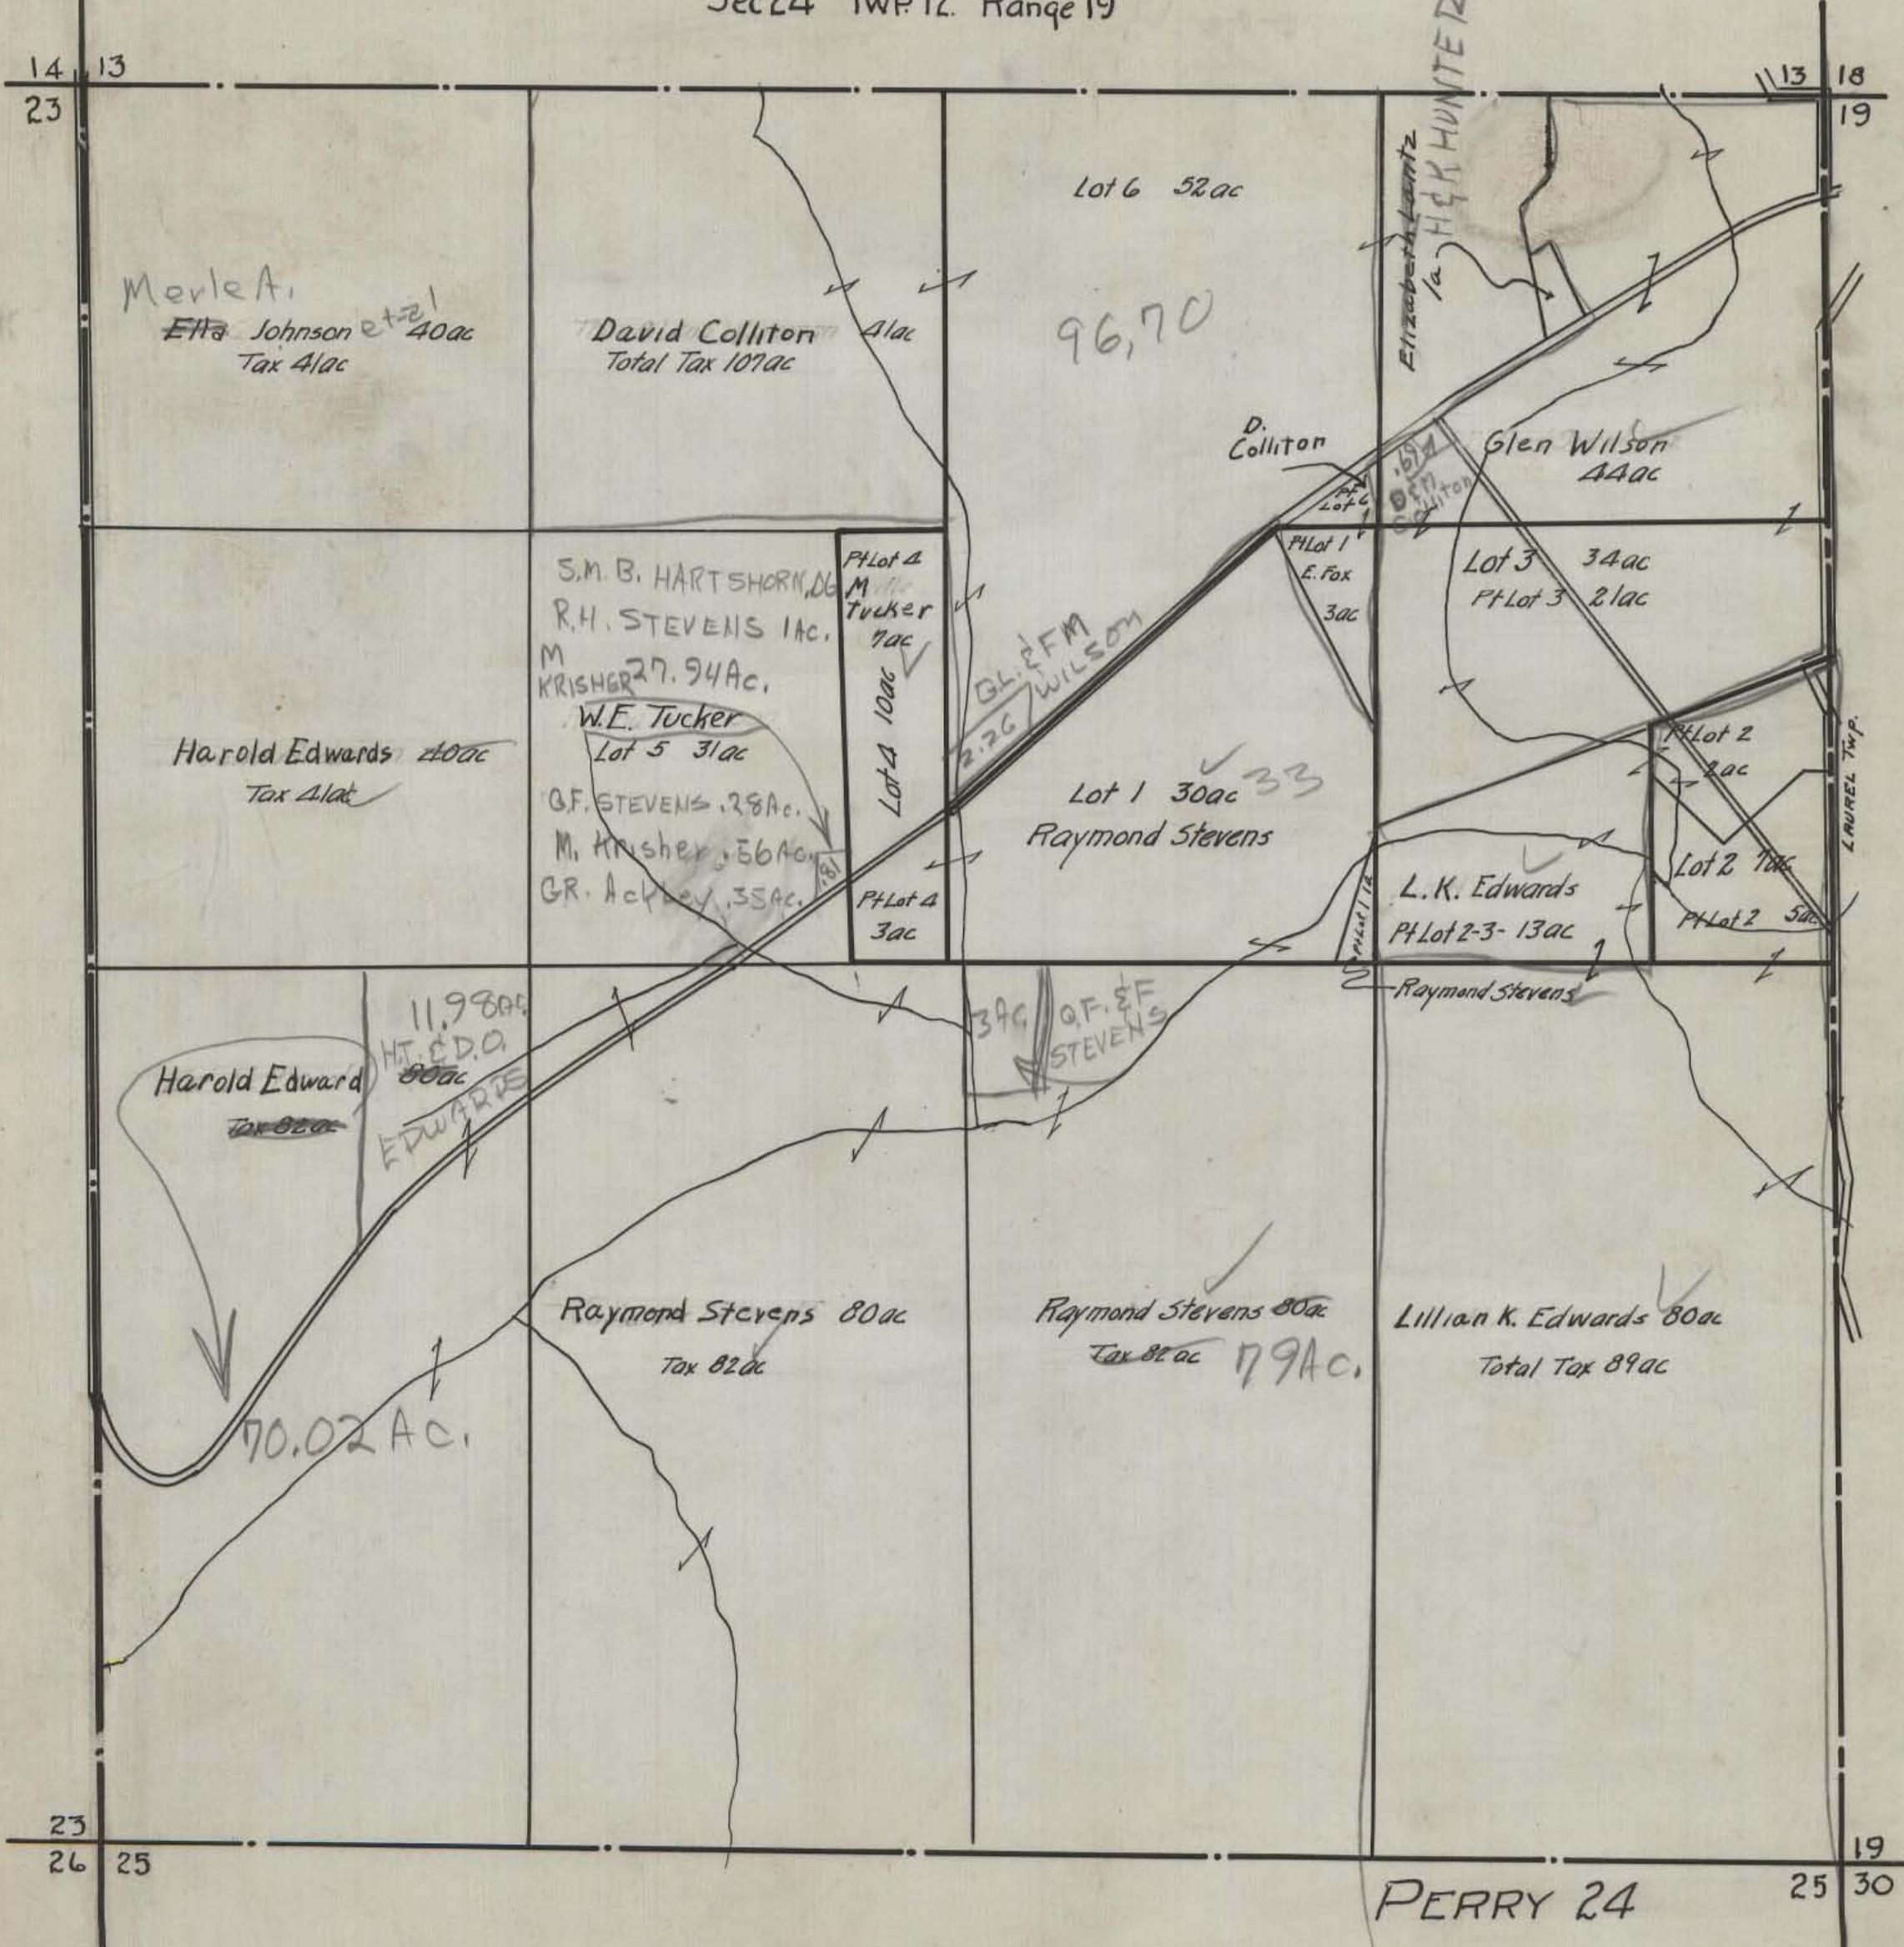


HOCKING COUNTY STATE OHIO

R.W.S 1945

SEC 25 TWP 12 RANGE 19

PERRY TWP


NORTH

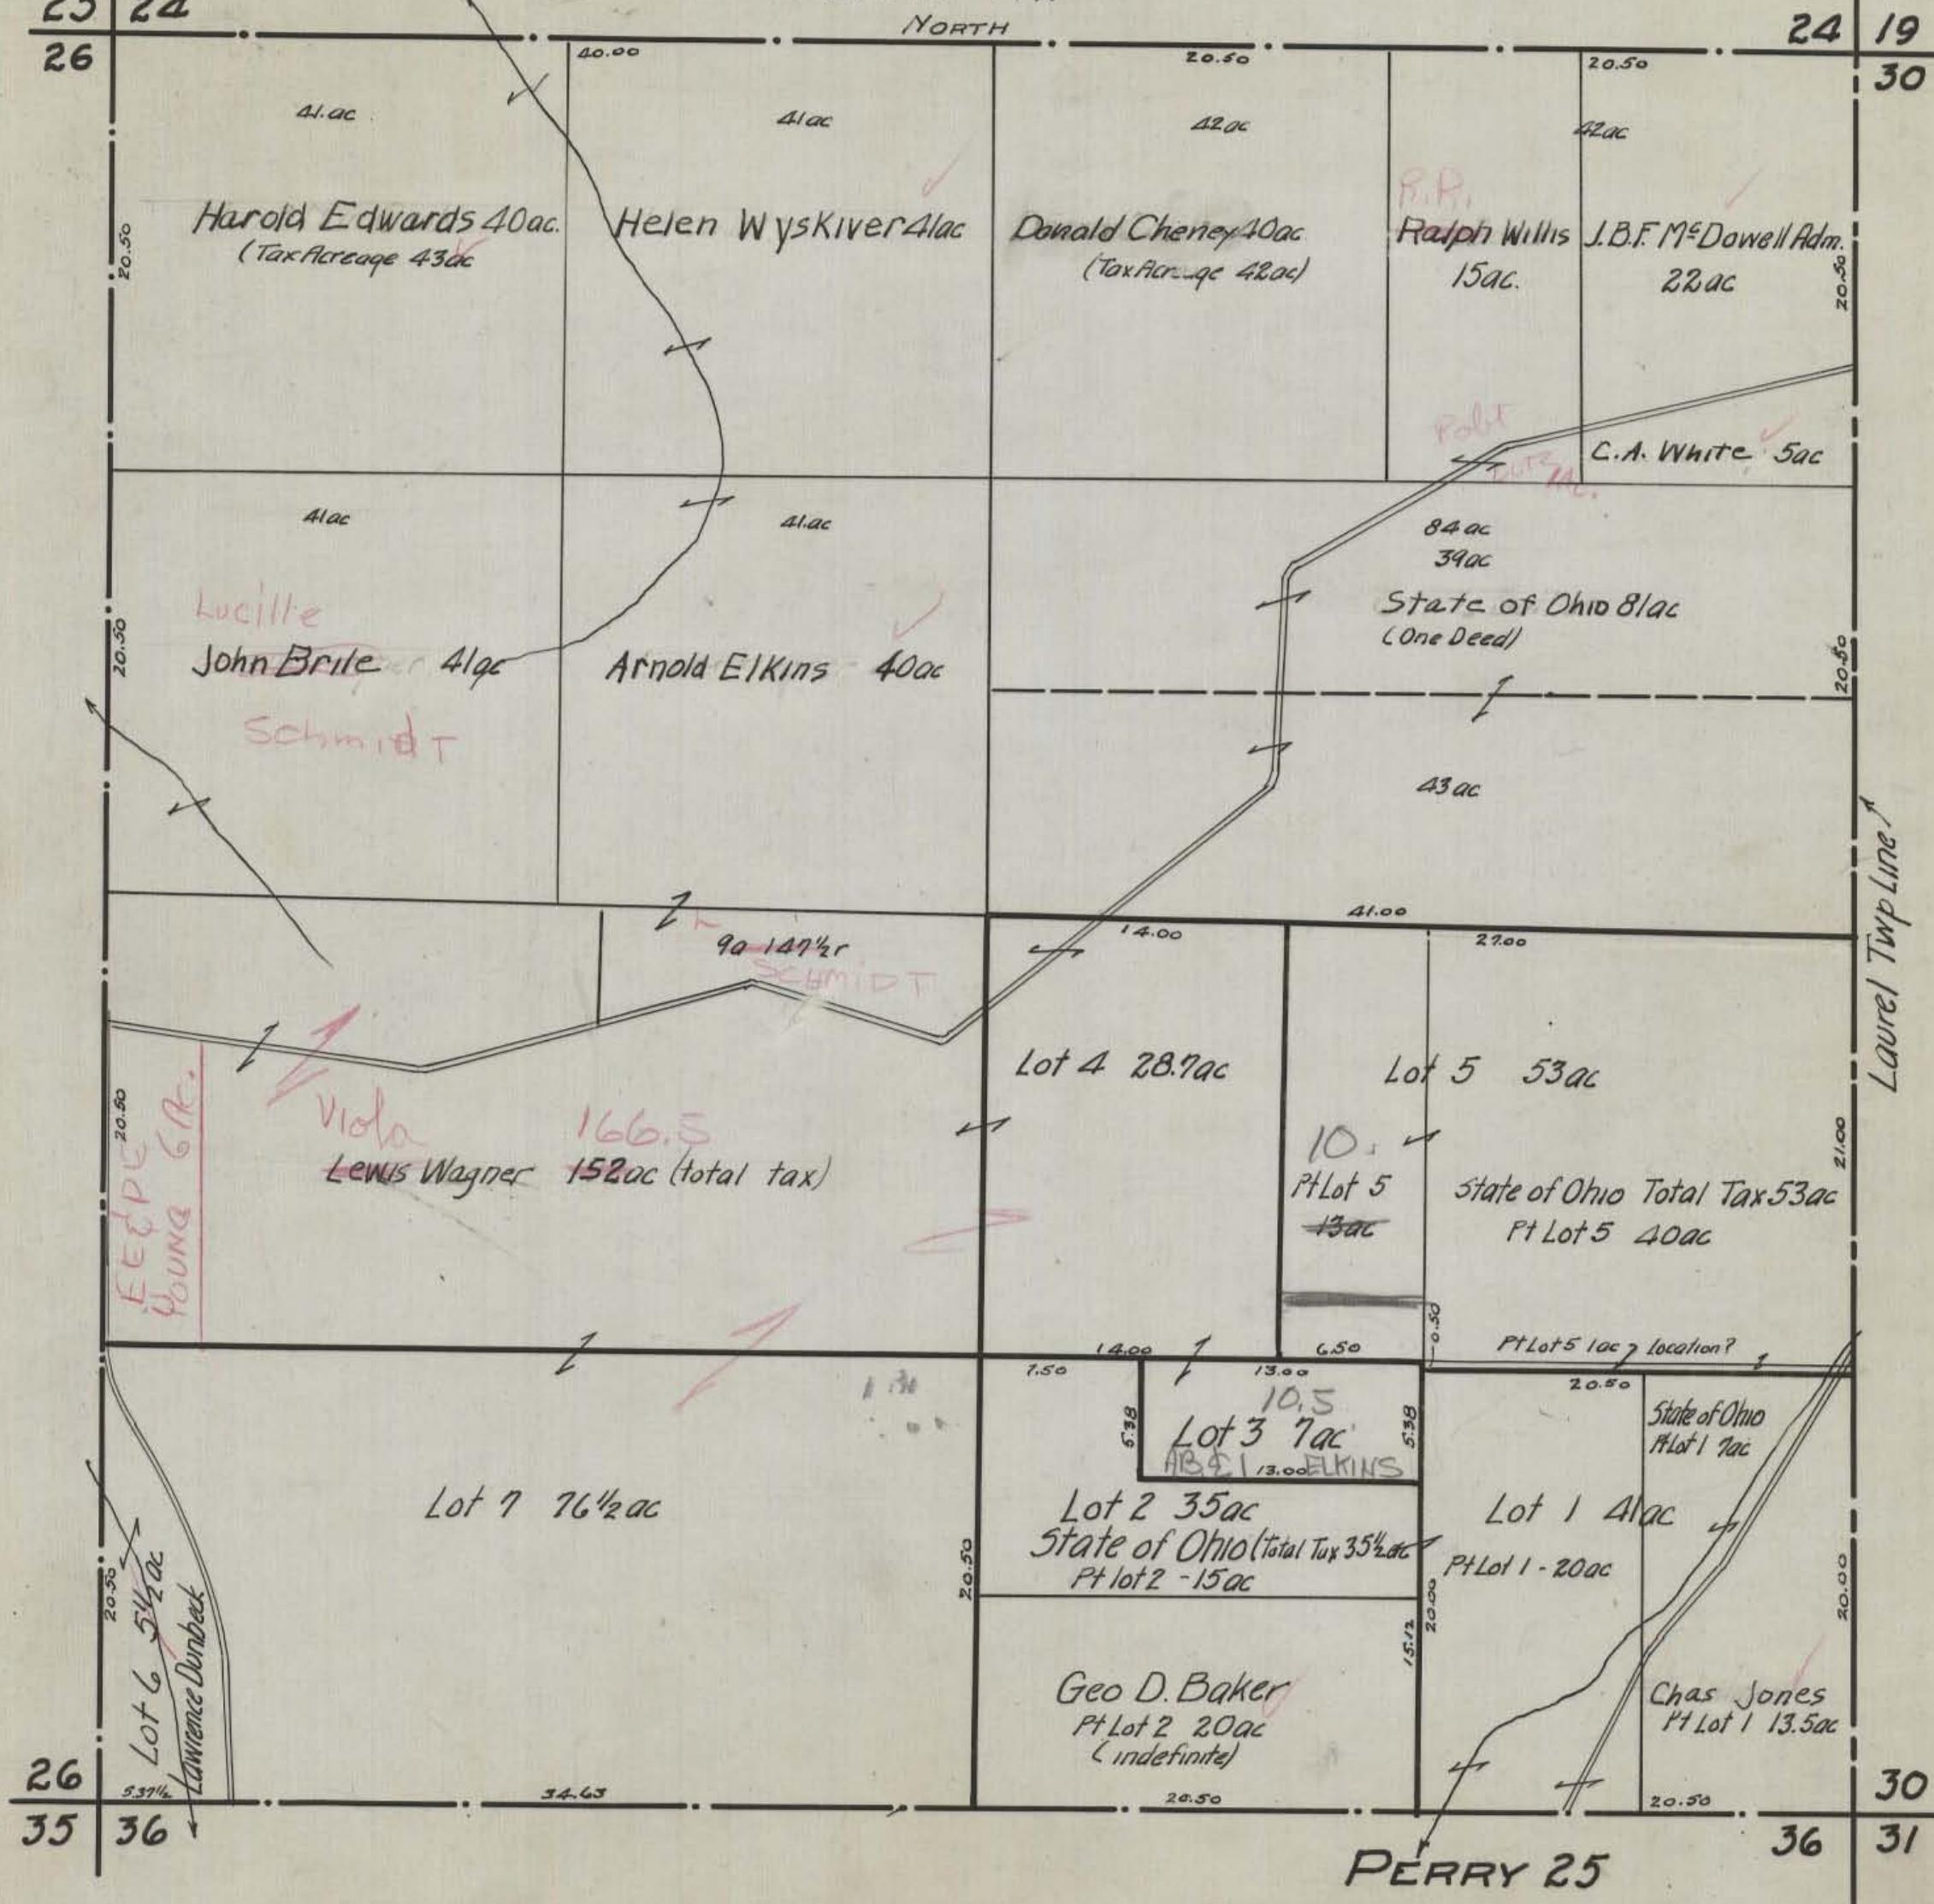

HOCKING COUNTY STATE OHIO

Sec. 26 Twp 12 Range 19


PERRY TWP

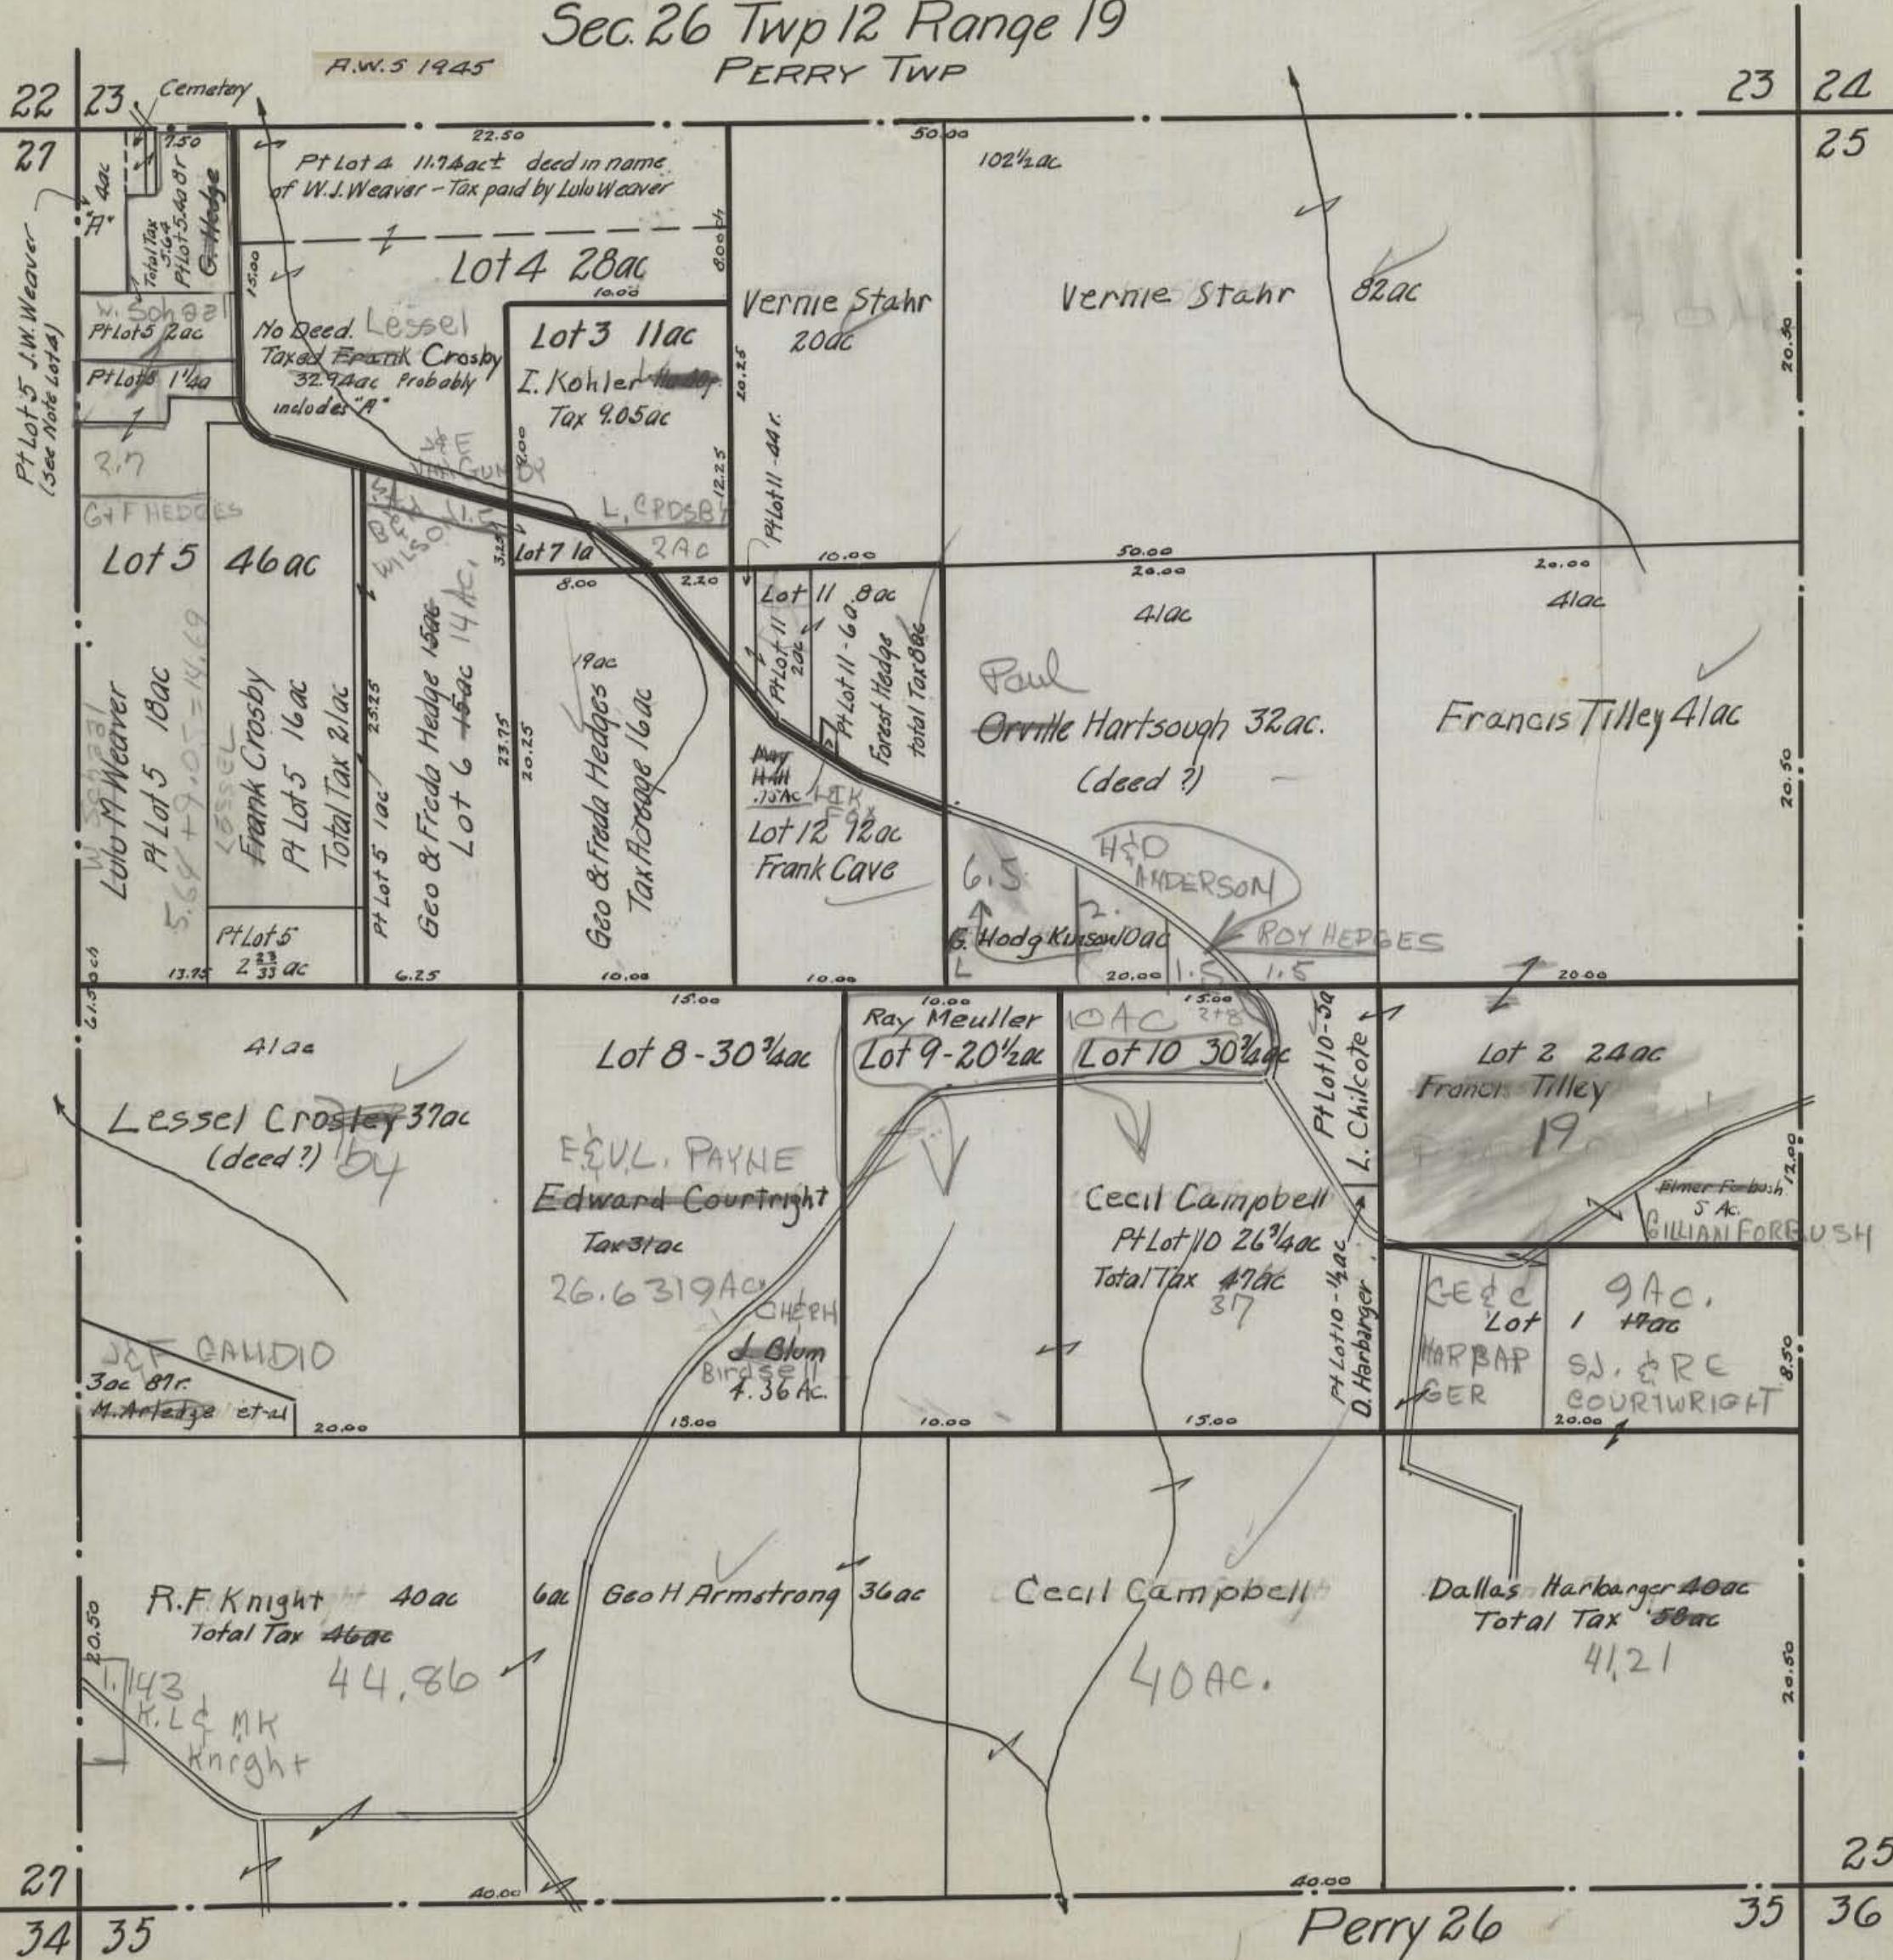

HOCKING COUNTY STATE OHIO

SEC 27 TWP 12 RANGE 19

P.W.S March 1945 PERRY TWP

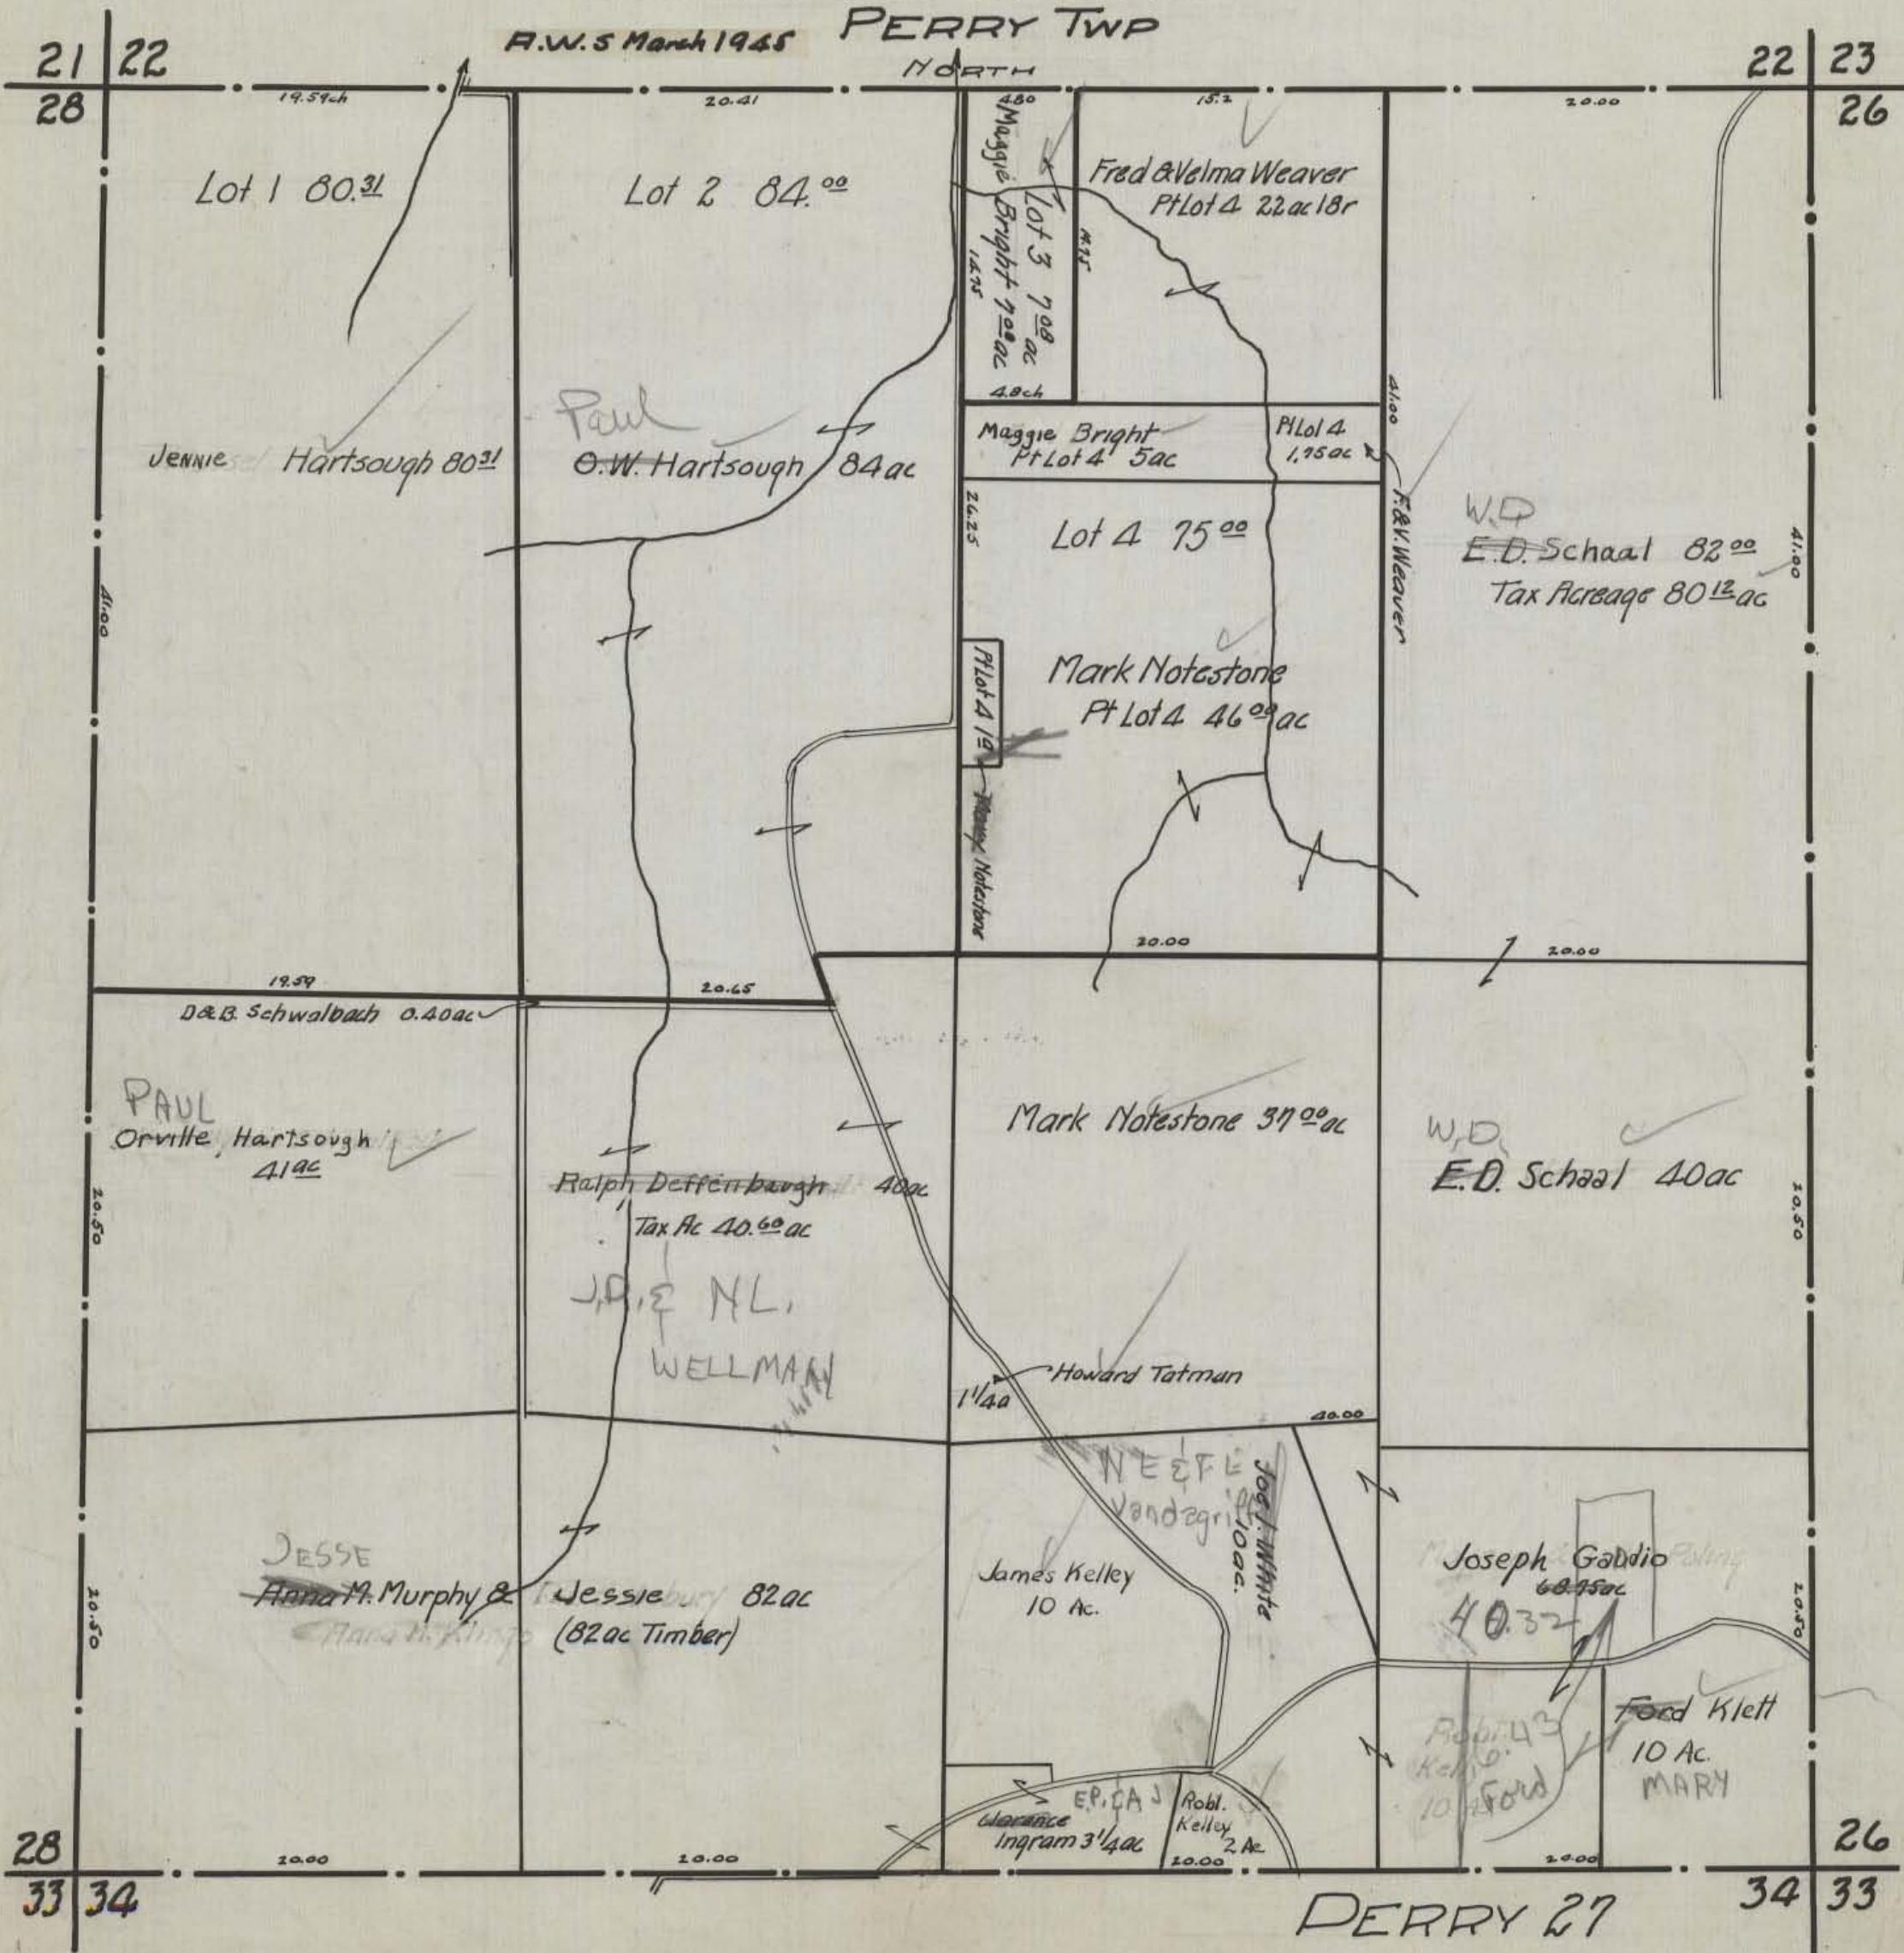


HOCKING COUNTY STATE OHIO

SEC 28 TWP 12 RANGE 19

R.W.S March 12 '45

PERRY TWP

NORTH

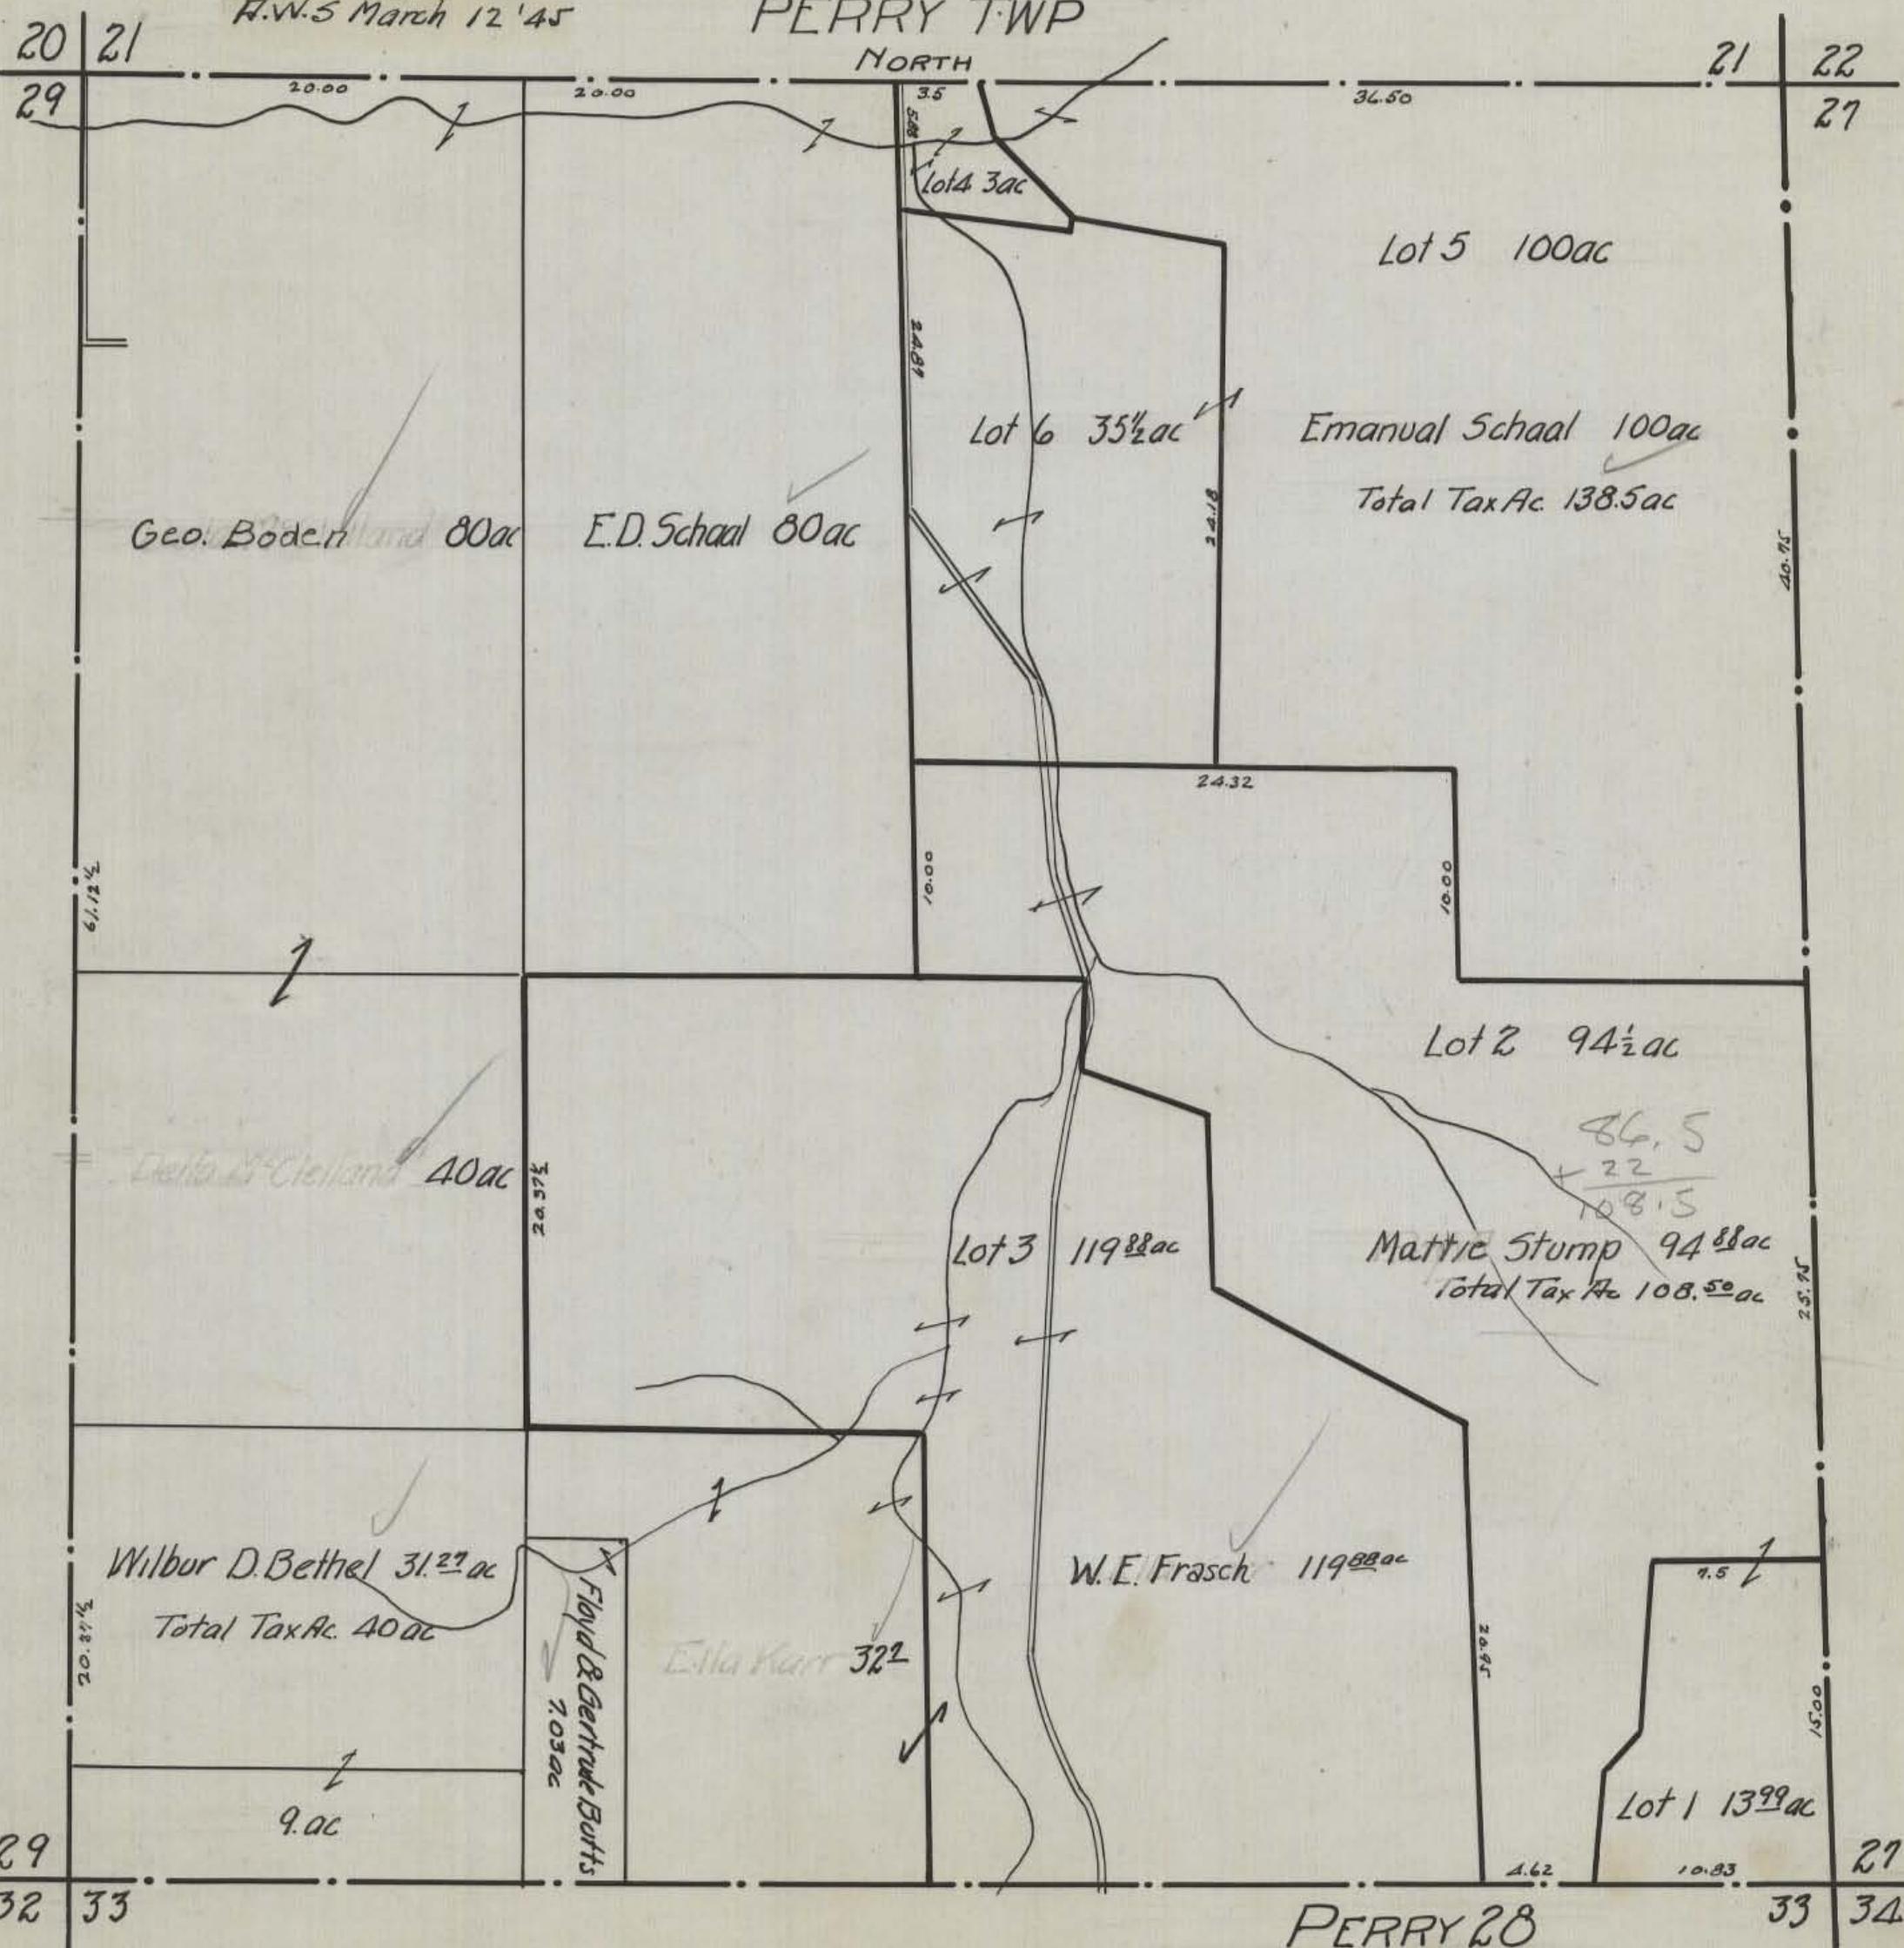


HOCKING COUNTY STATE OHIO

A.W.S. March 12 45

SEC 29 TWP 12 RANGE 19


PERRY TWP

North

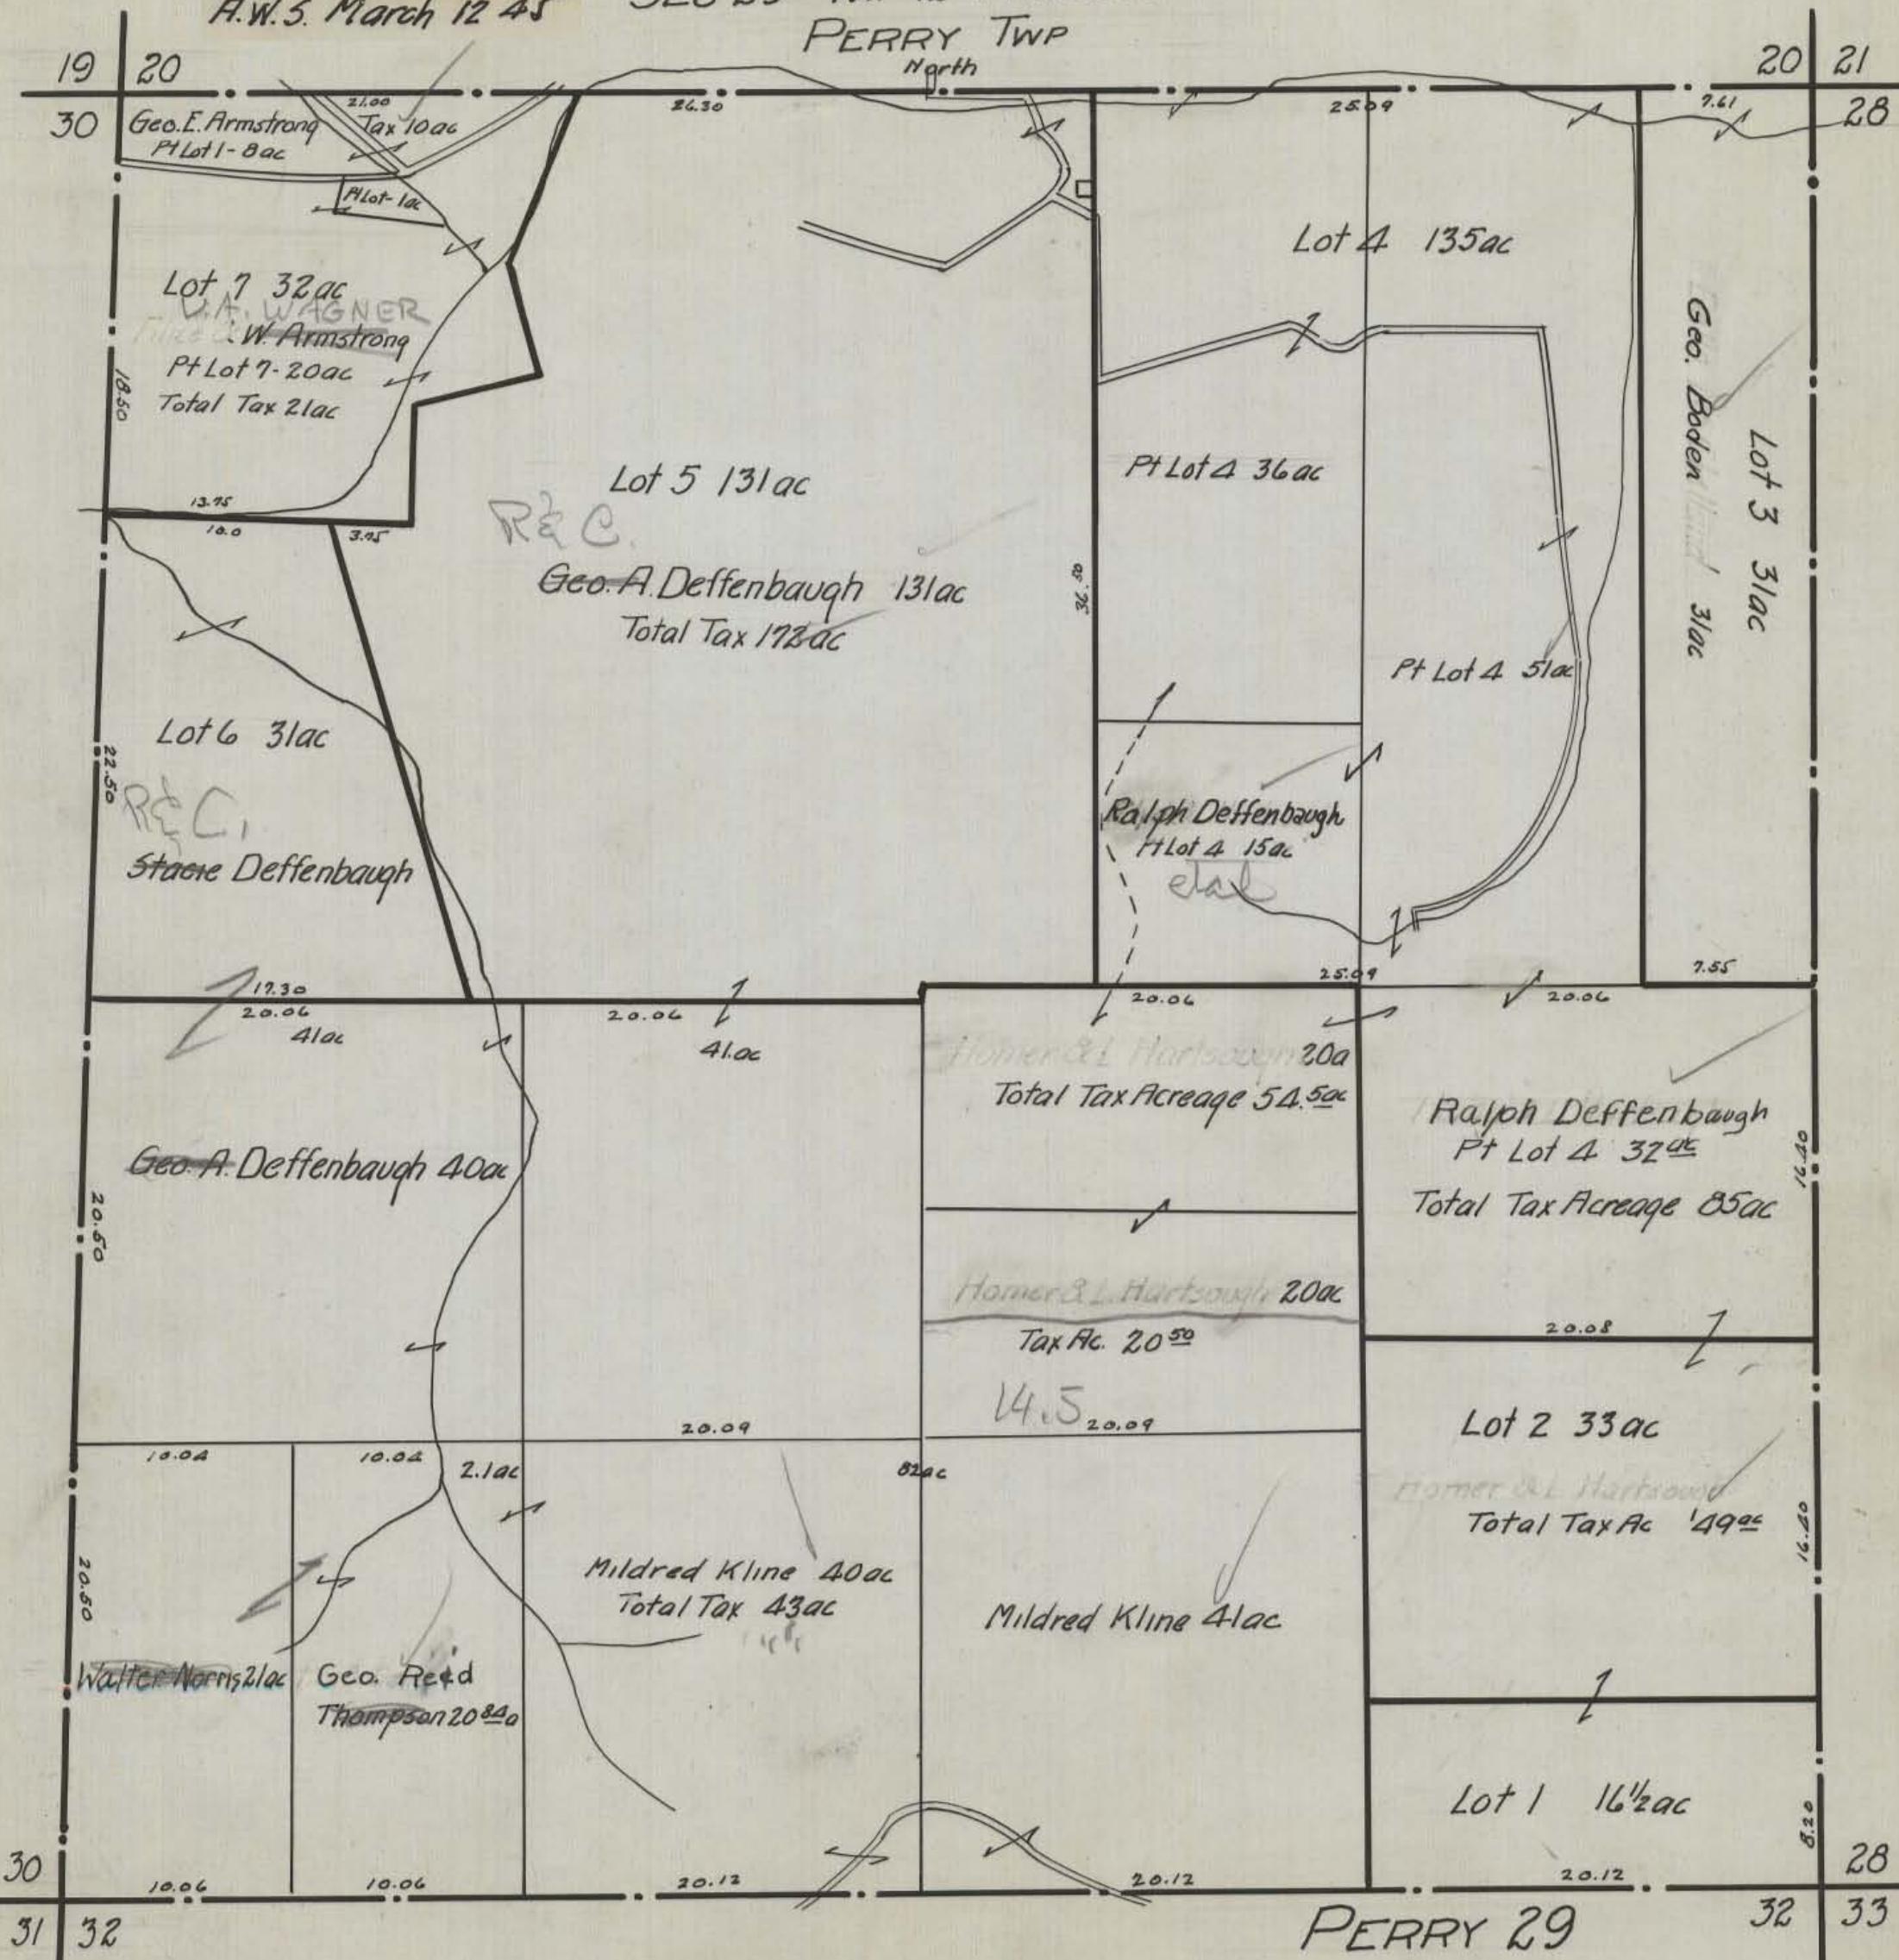

HOCKING COUNTY STATE OHIO
SECTION NO. 30 TWP. 12 RANGE 19

SCALE: 500 FEET TO 1 INCH

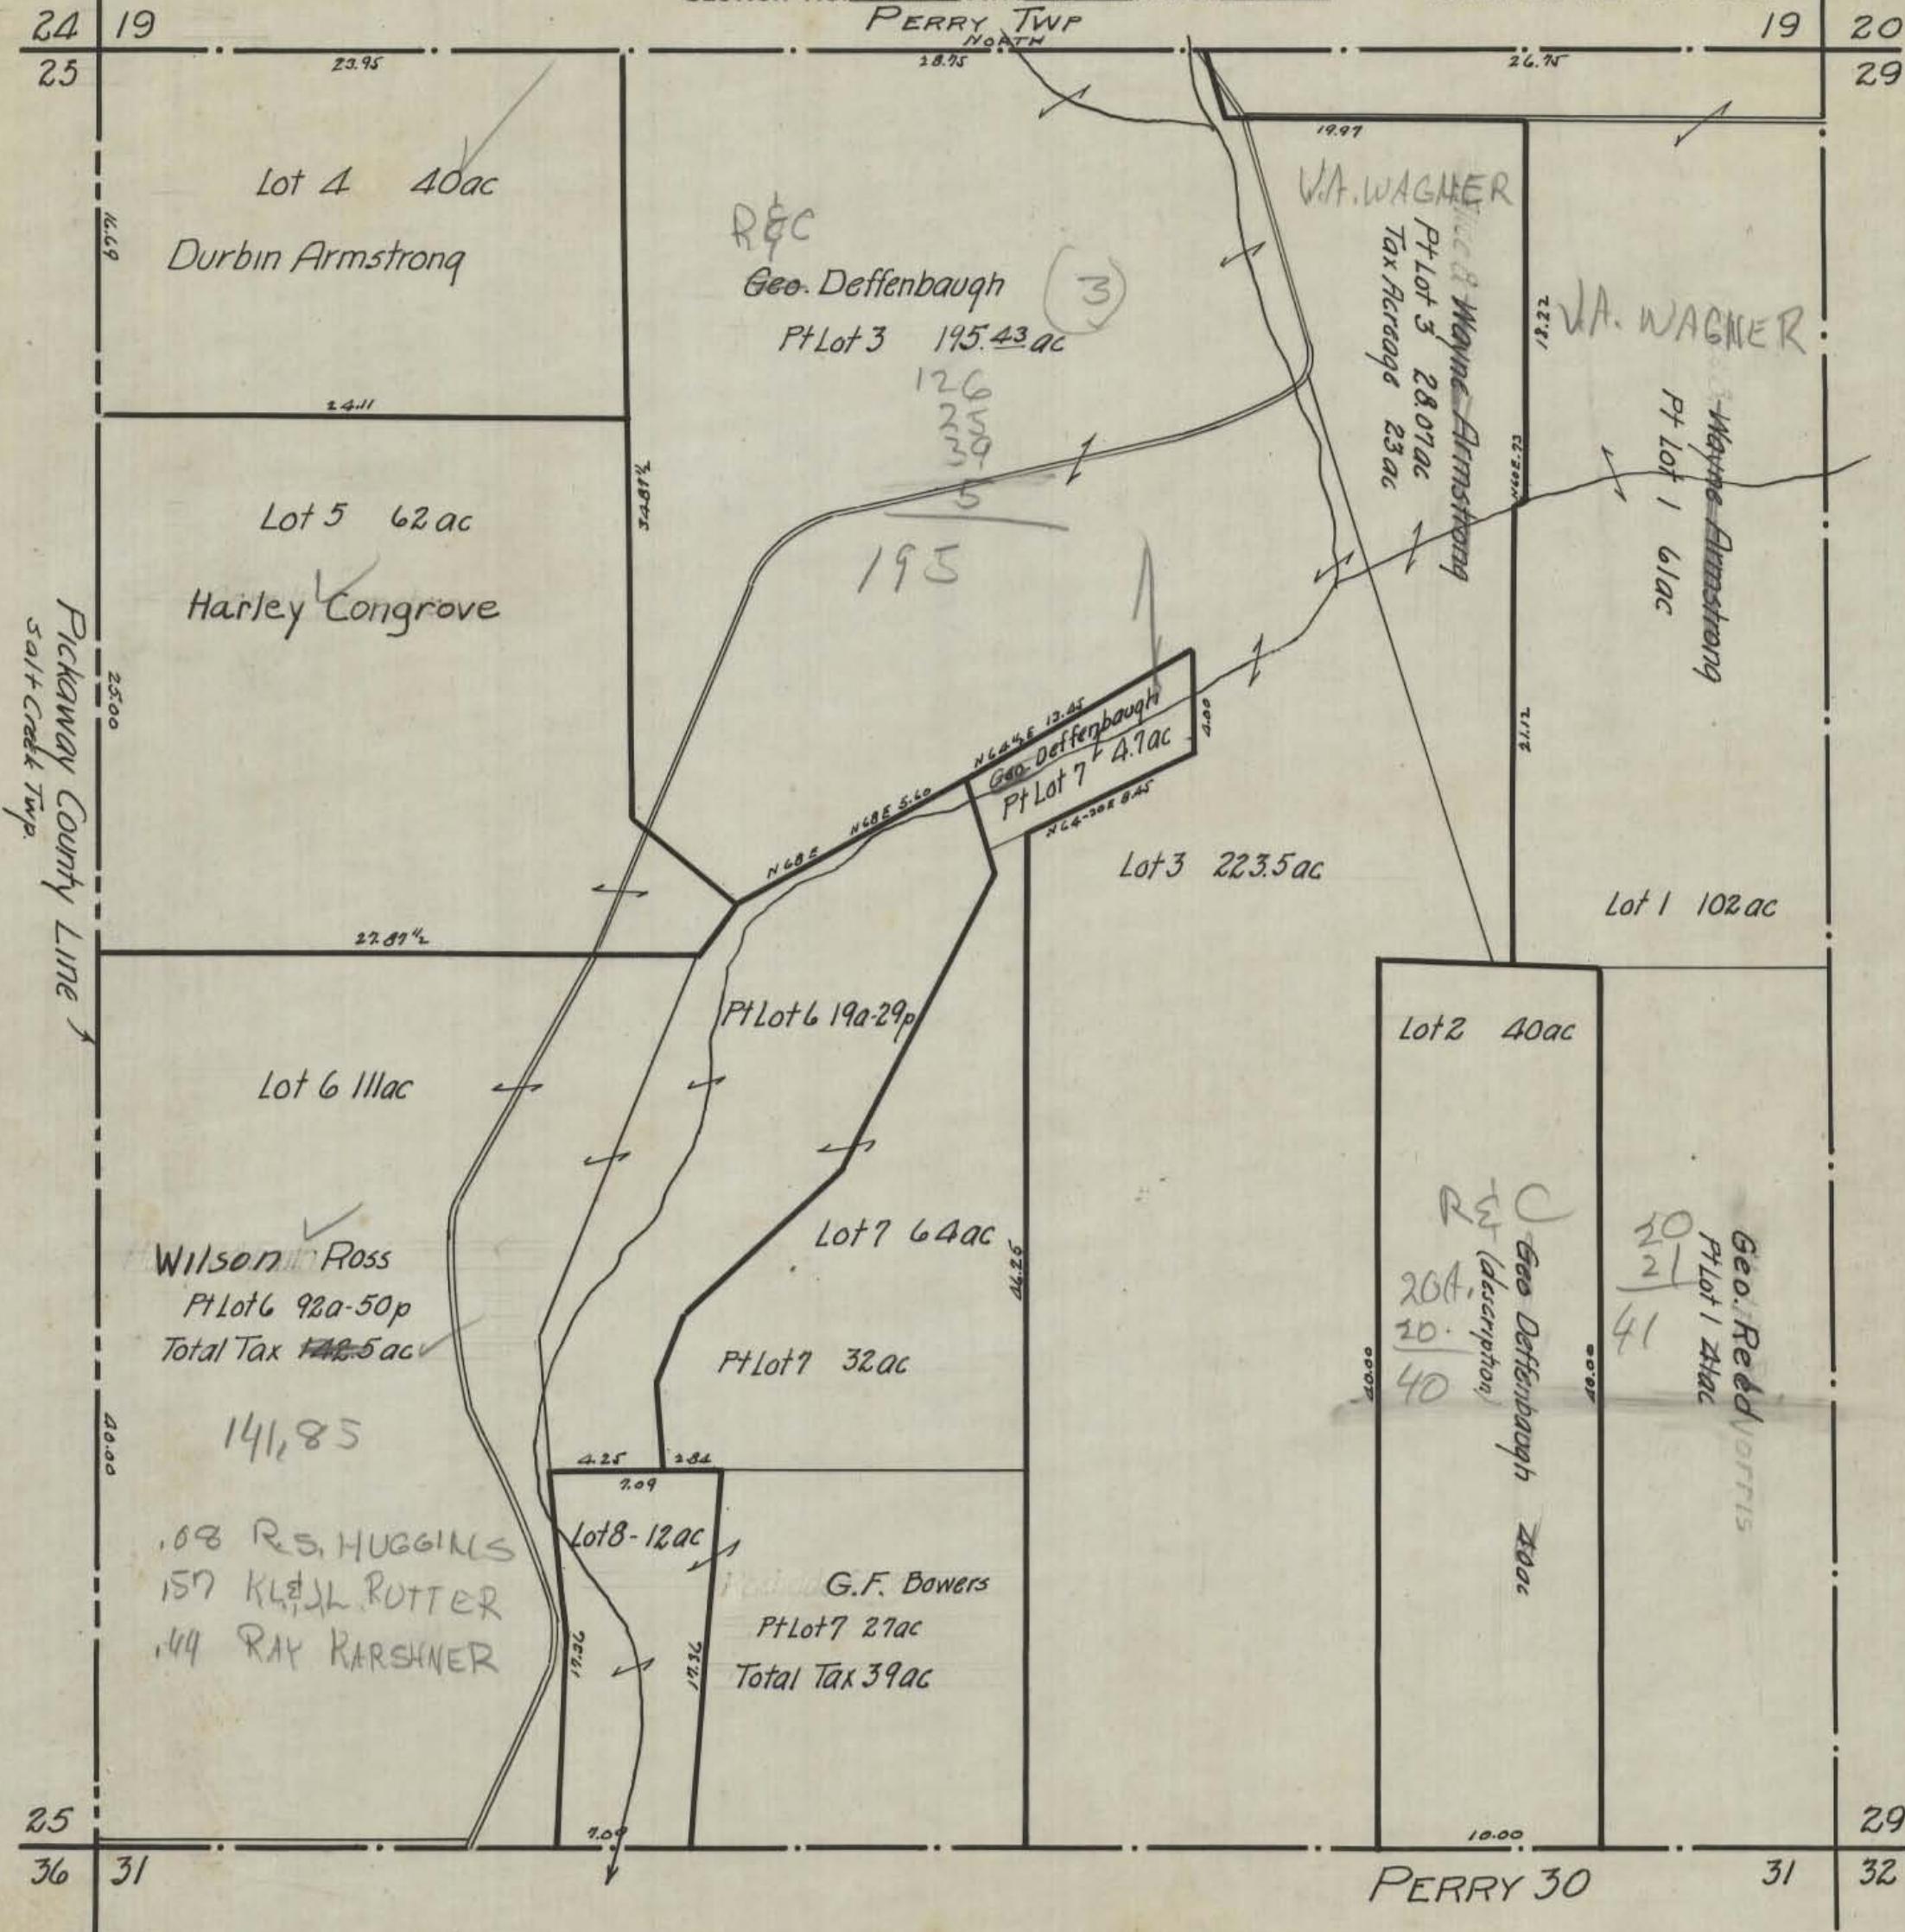

HOCKING COUNTY STATE OHIO
SECTION NO. 31 TWP. 13 RANGE 19

Fairfield County
Clear Creek Twp Madison Twp
Sec 25 Sec 30 A.W. Seabright Apr 17 1939

PERRY TWP.

NORTH

SCALE: 500 FEET TO 1 INCH

Madison Twp
Fairfield Co
Sec. 29

Sec. 36
Clear Creek Twp
Fairfield Co

Marvin Sharp
Lot 11 65.21 ac.

Mary & Layman Sohrensses
Lot 10 40 ac

H.E. Winland
Pt Lot 3 108 ac
Total Tax Acreage 154.62

Vance Sharp (deed incorrect)
Pt Lot 3 3.30 ac

E.D. Lutz
Pt Lot 2 10 a 19 p
Total Ac. 14 ac

Pt Lot 3 68.75 ac

Albert Haynes

6

Sec 1
Salt Creek Twp
Pickaway Co.

SOUTH

PERRY 31 T13 R19.

32

5

R.B. Conley
Lot 9 13 ac.

SAC
F & E
McNabb

GEO. REID

Fred McNabb
Lot 6 40 ac

Olive Melva Spybey
Lot 5 69 ac.

Pt Lot 4
4 1/4 a - 35 p.

Pt Lot 1
5 ac

Pt Lot 4 14 1/2 ac

E.D. Lutz
Pt Lot 4 71.69 ac
Total Tax Acreage 98 ac.


32

EAST

WEST

HOCKING COUNTY STATE OHIO
SECTION NO. 31 TWP. 12 RANGE 19

SCALE: 500 FEET TO 1 INCH

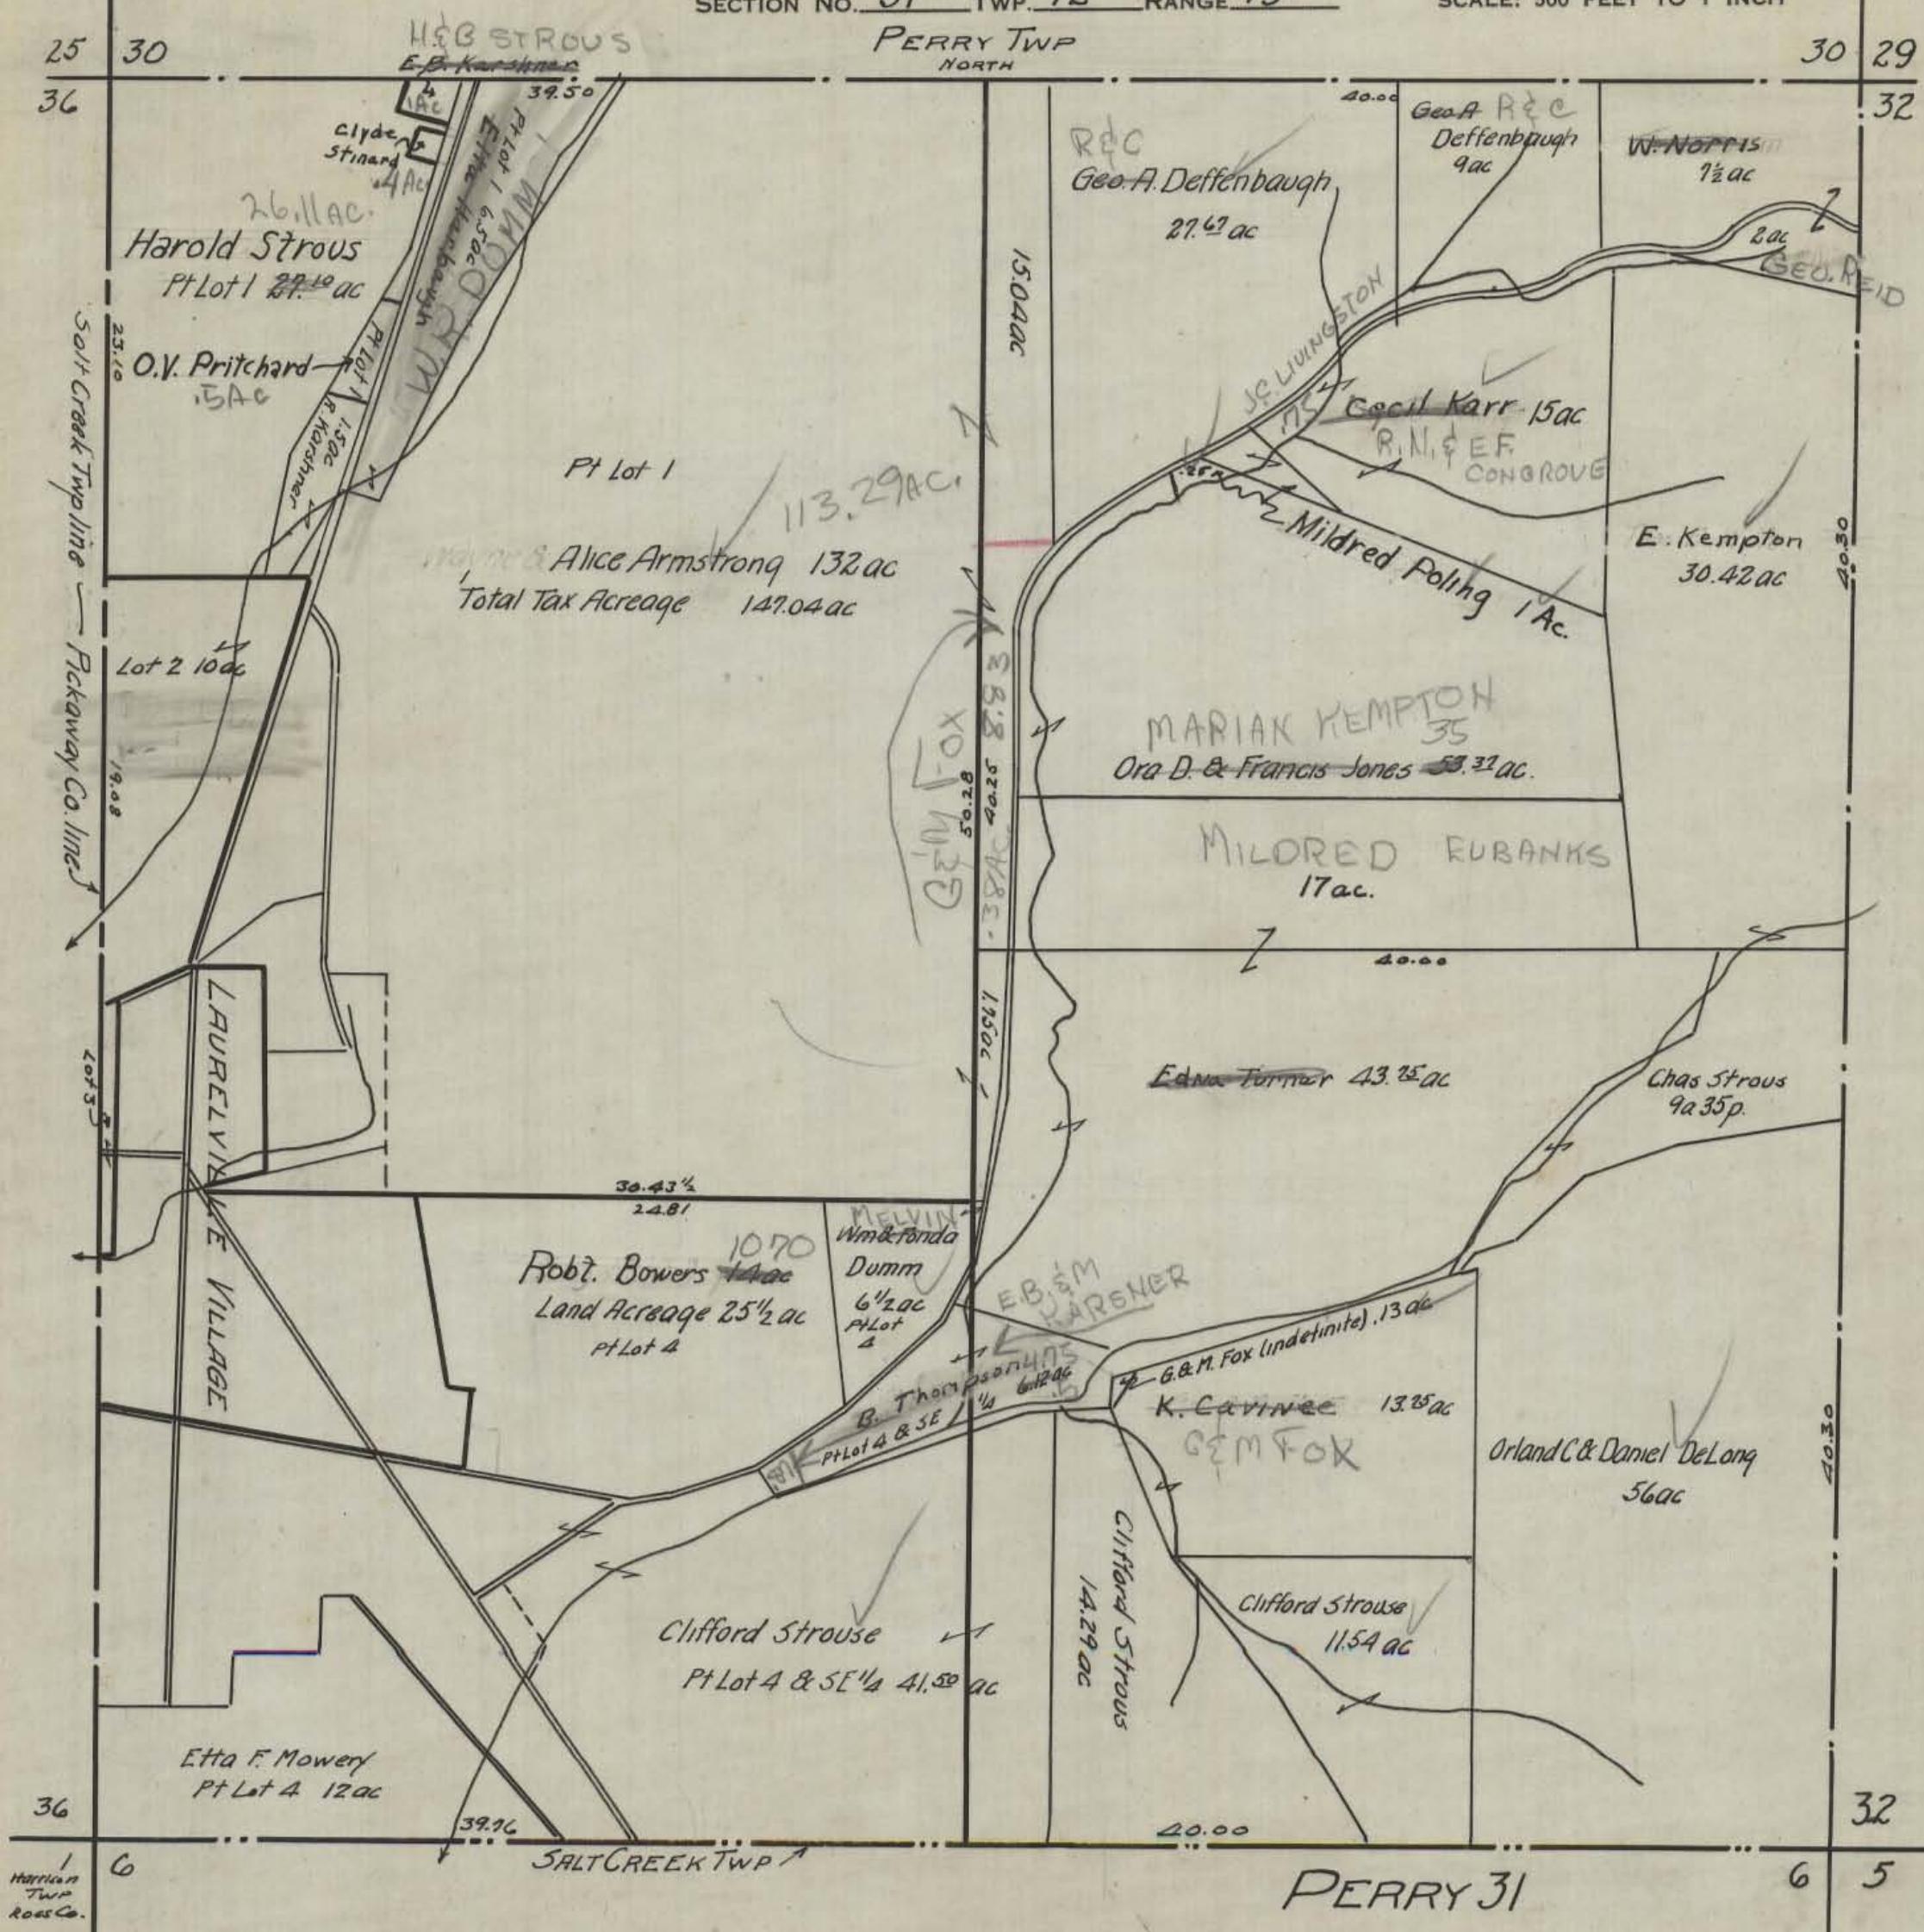

HOCKING COUNTY STATE OHIO
SECTION NO. 32 TWP. 13 RANGE 19

PERRY (Twp 13)

NORTH

SCALE: 500 FEET TO 1 INCH

~~Madison Twp~~
Fairfield Co
Z8

AWS Apr. 18 1939

Madison Twp
Fairfield Co
30 29


38.78

19.39

19.39

31

33

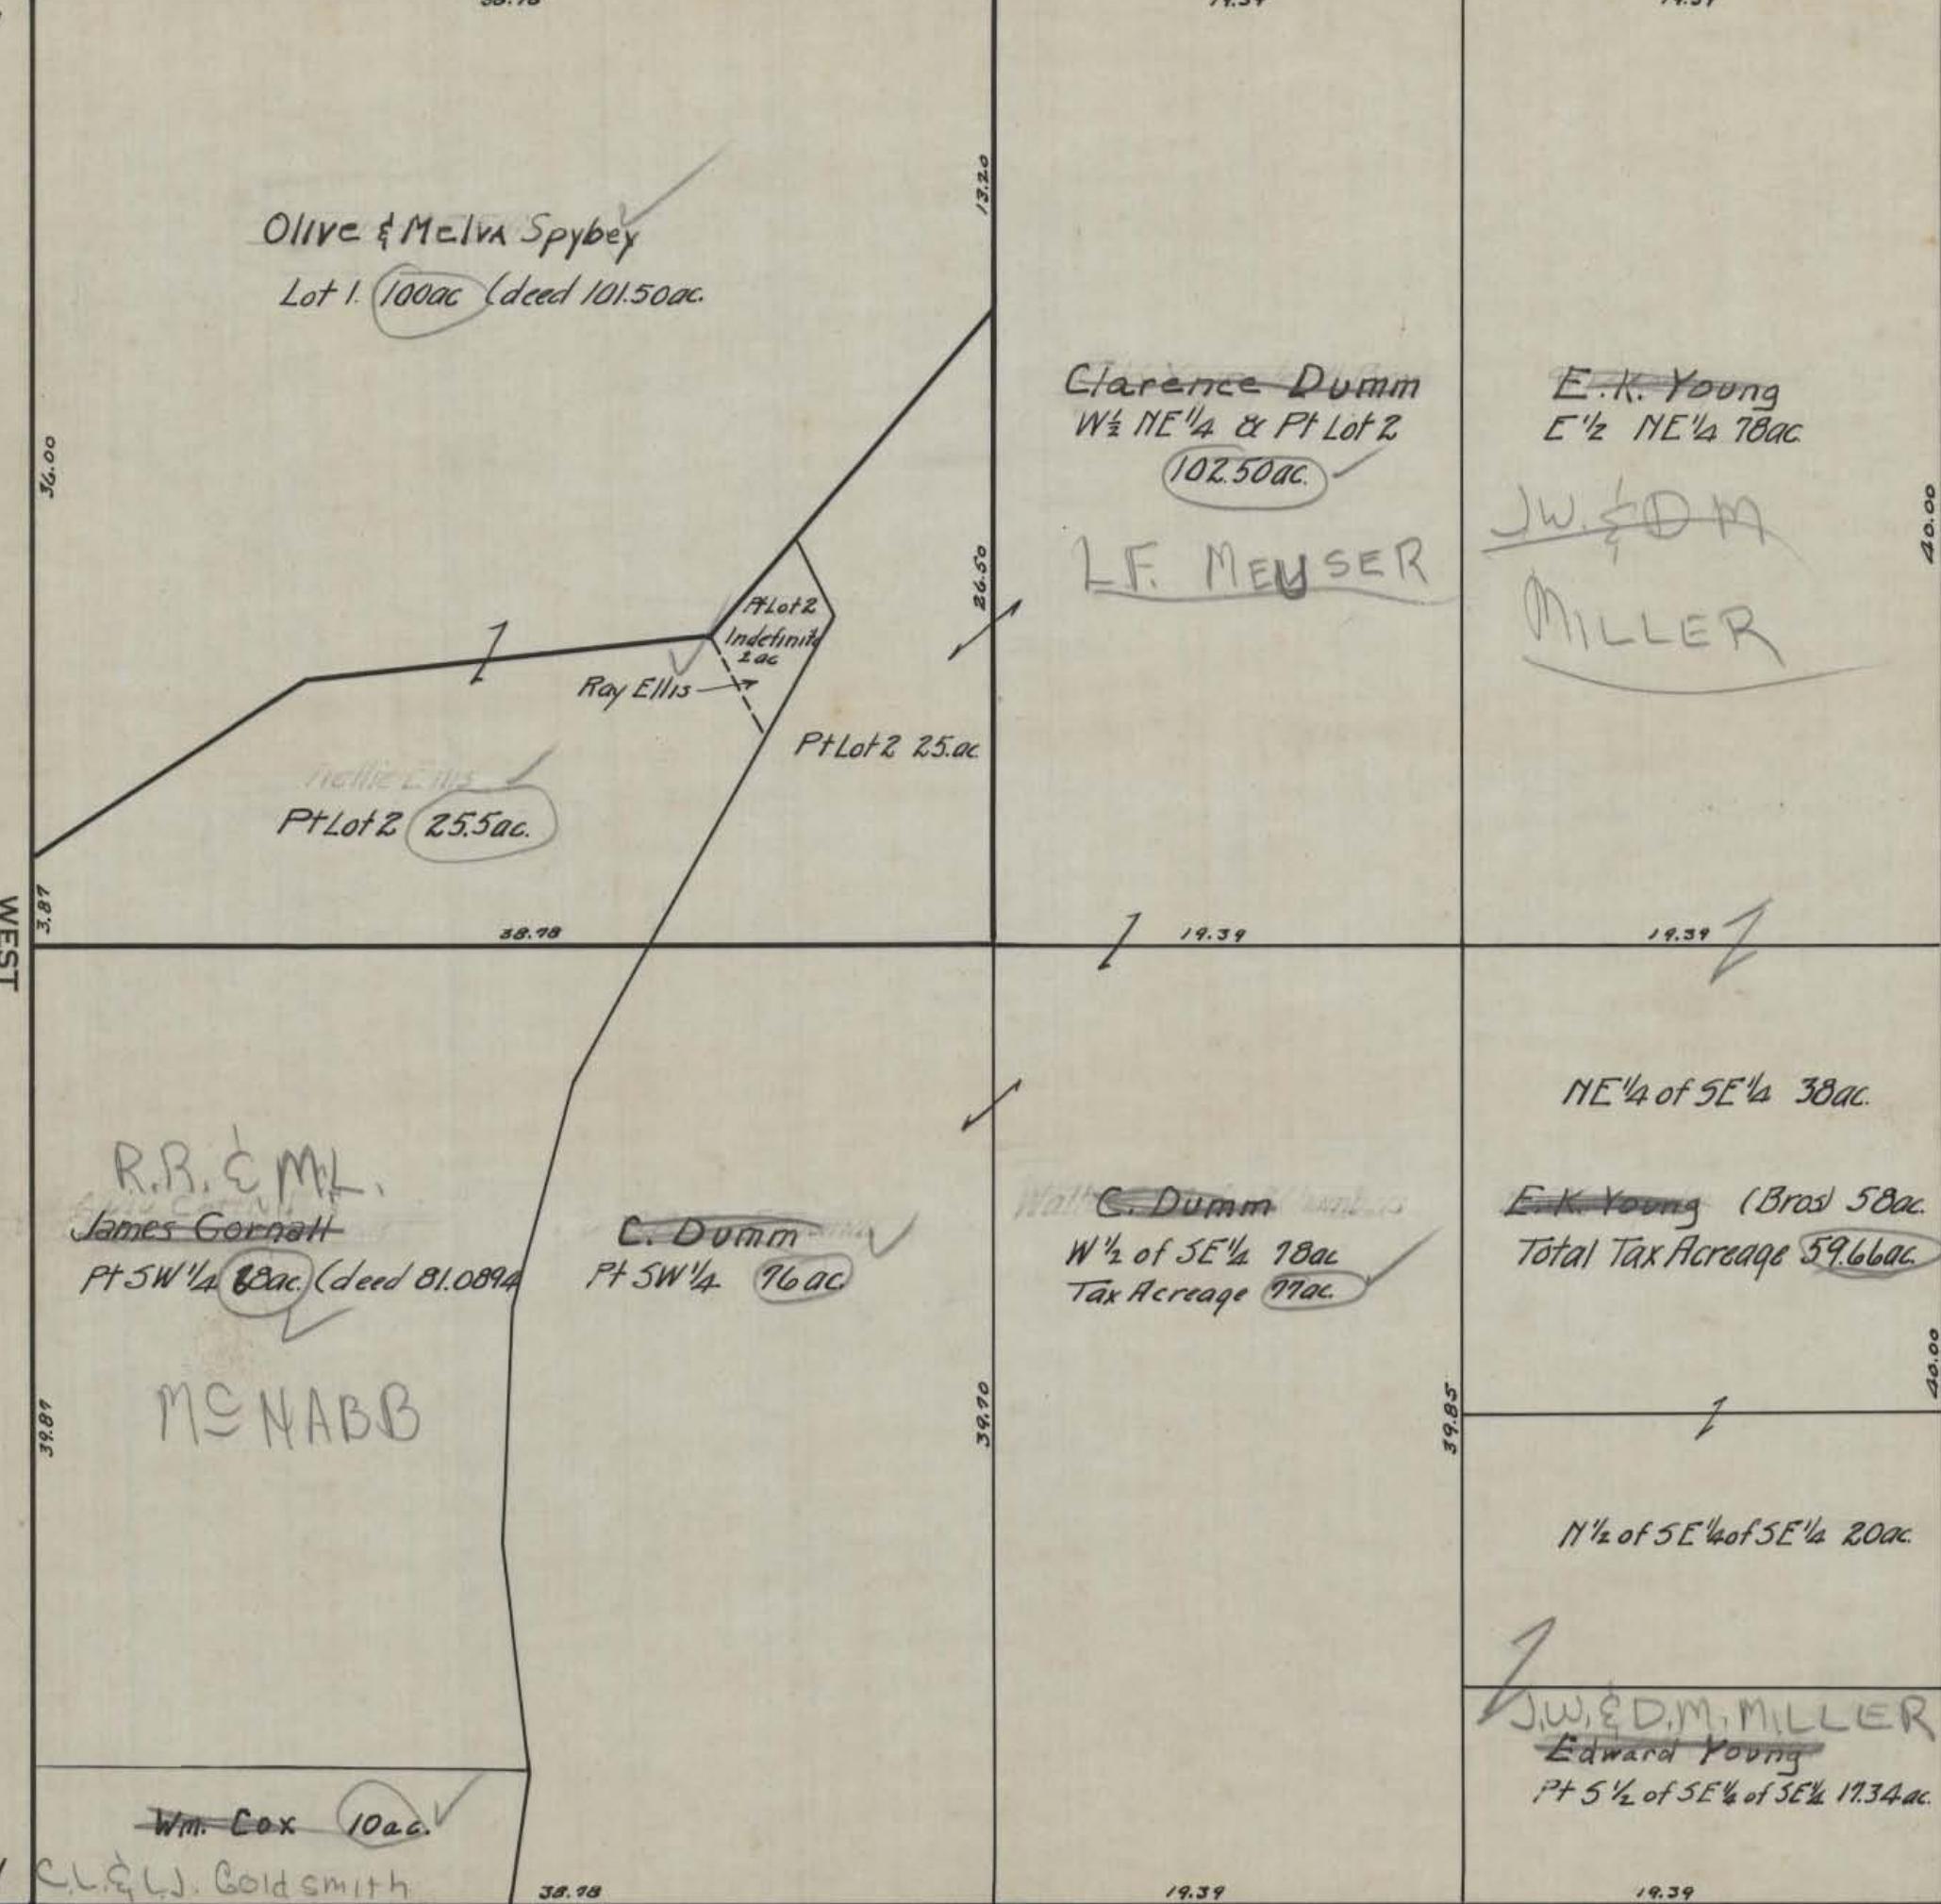

31 6 5

SOUTH

19.39

PERRY 32 T13.

33

5


4

HOCKING COUNTY STATE OHIO

Sec 32 TWP 12 Range 19

PERRY TWP

North

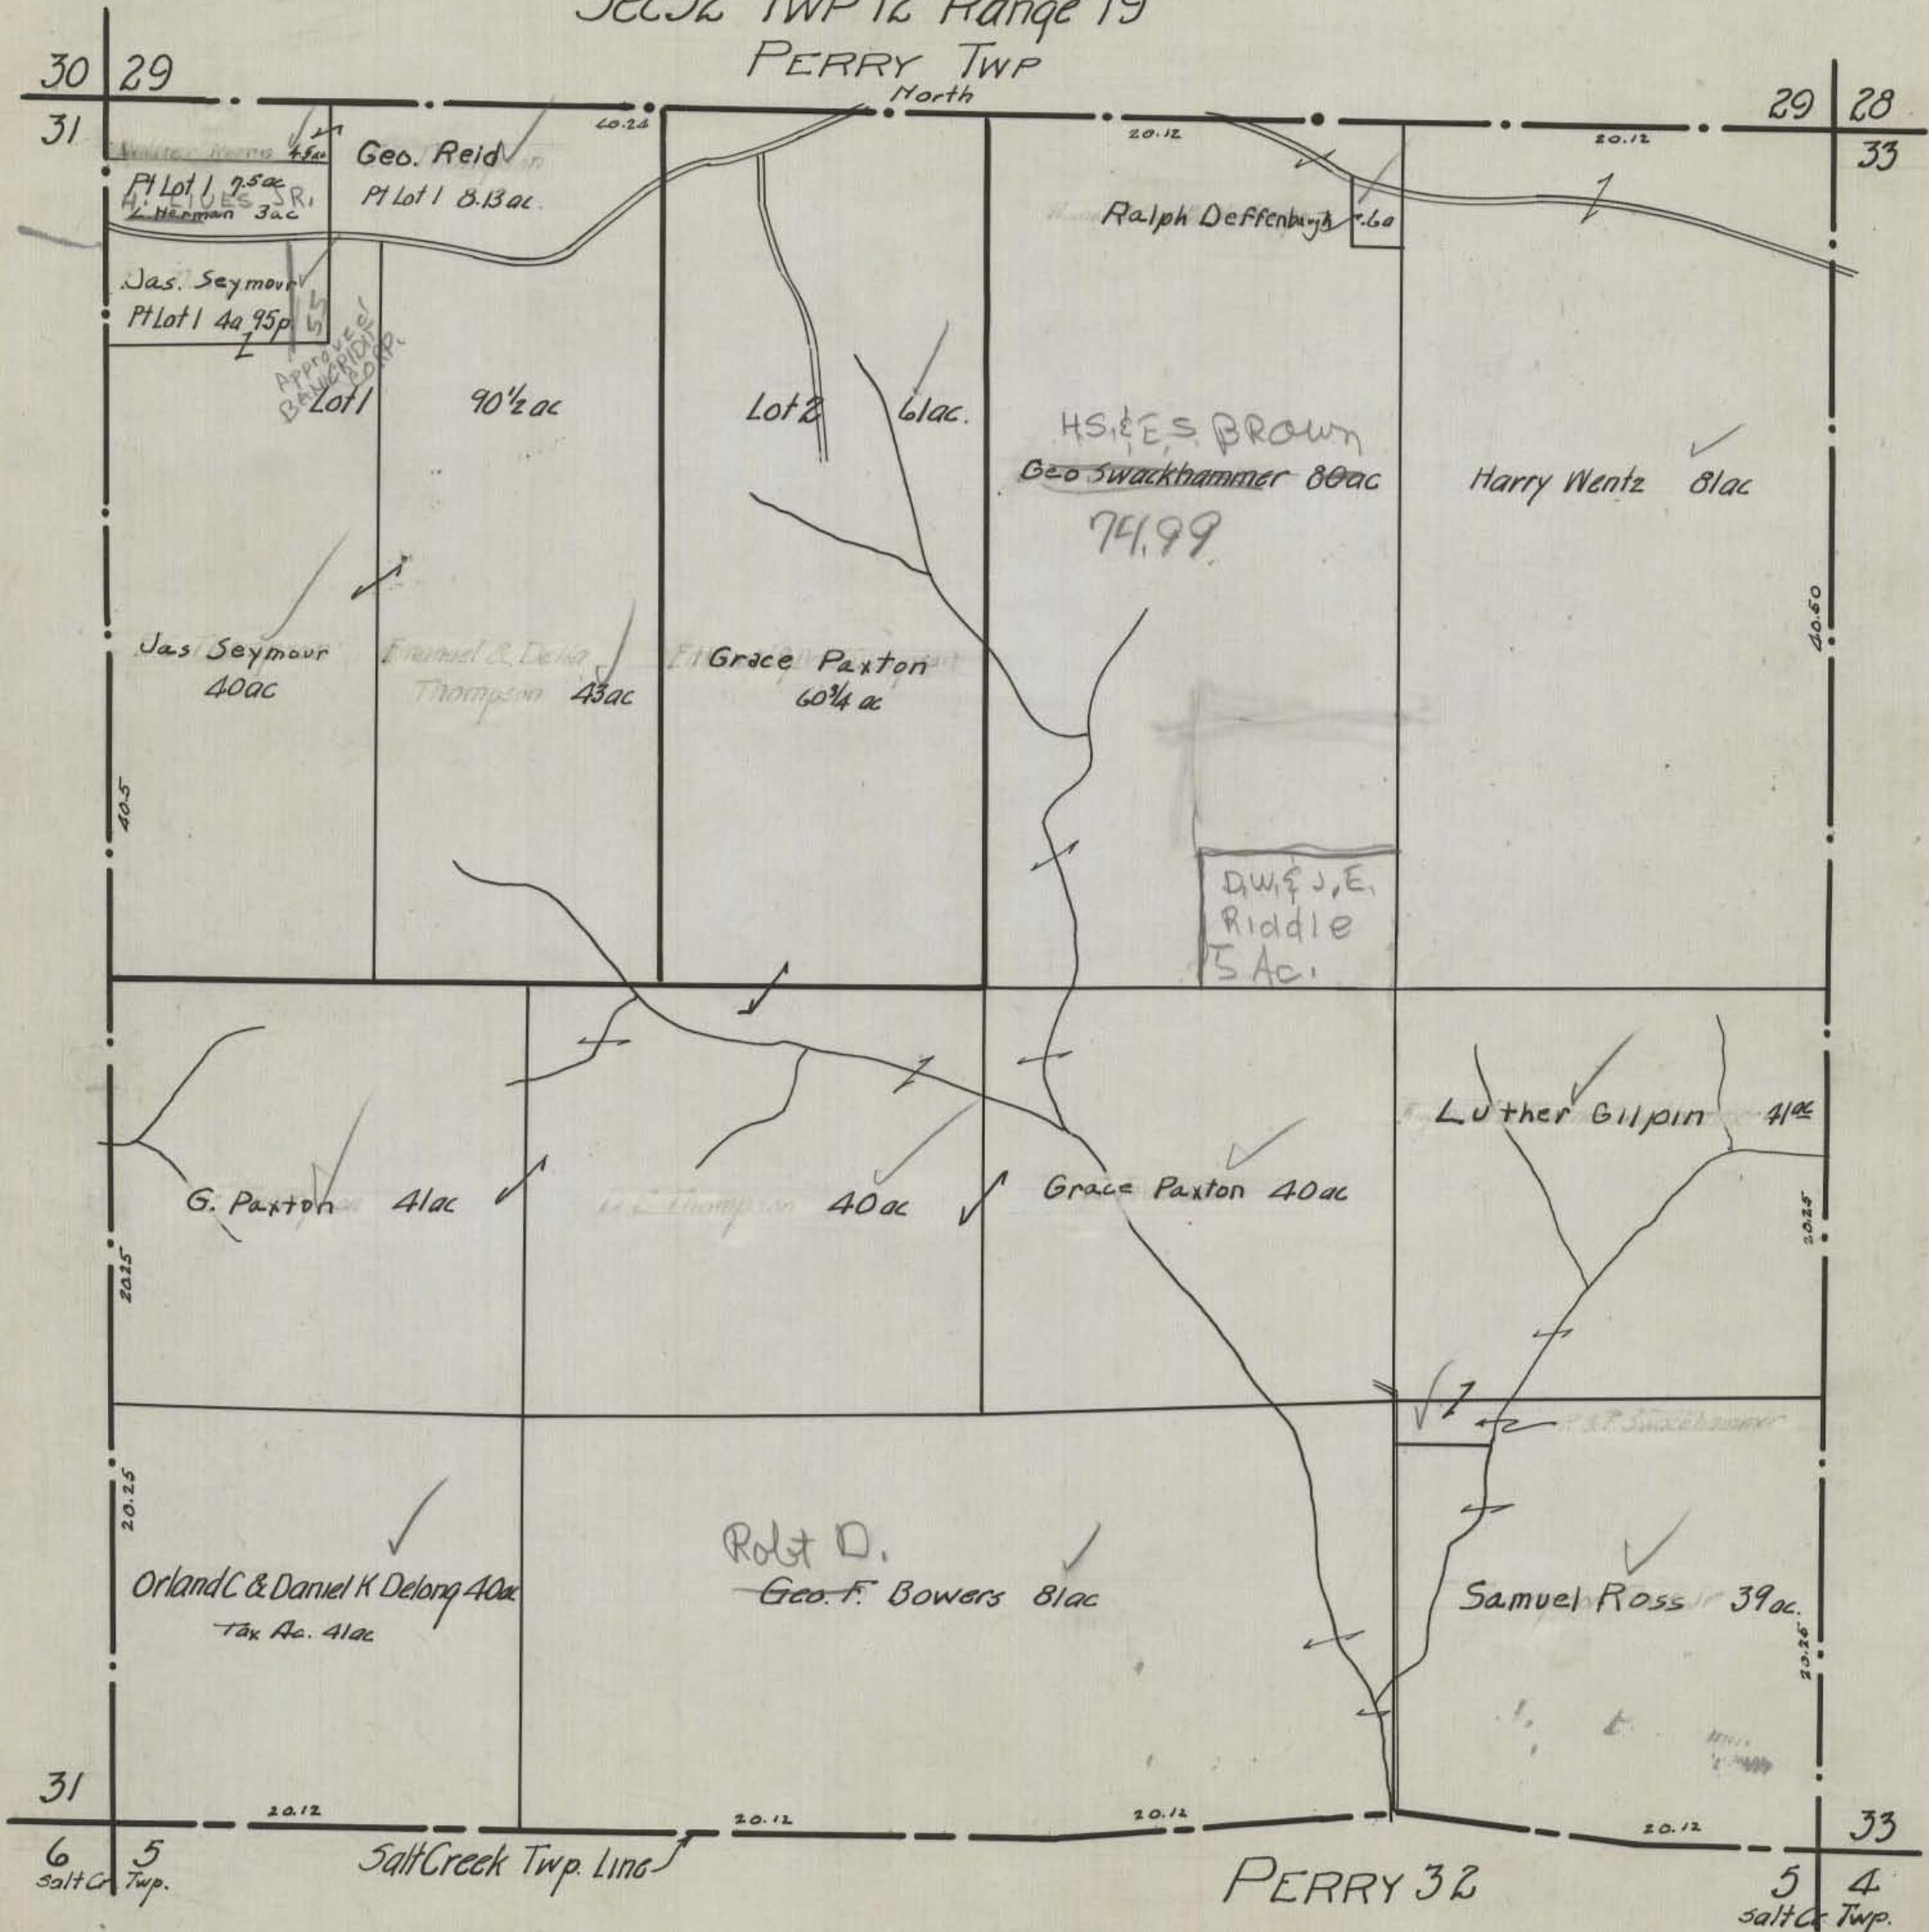

HOCKING COUNTY STATE OHIO
SECTION NO. 33 TWP. 13 RANGE 19

PERRY Twp 13

NORTH

SCALE: 500 FEET TO 1 INCH

Madison Twp
Fairfield Co
27

Madison
Fairfield
Co
29
Twp
28

AWS Apr 19 1939

32

34

12.485	12.885	12.985	19.13	19.13	34
J.W. & D.M. E.K. Young Lot 1 <u>49.10ac.</u> MILLER	F.B. Chambers Lot 2 <u>51.43ac.</u>	Lloyd Julian Total Tax Acreage <u>51.00</u> Lot 3 <u>45.43ac</u>	NW $\frac{1}{4}$ of NE $\frac{1}{4}$ <u>37.83ac</u>	Casper Owen Hendrickson NE $\frac{1}{4}$ of NE $\frac{1}{4}$ <u>38ac.</u> (deed 37.83ac)	19.90

40.05	20.05	39.81	39.81	19.90
12.485	12.91	6.00	6.075	19.90

1.00	12.3ac	39.81
Bethany Cemetery		39.81

40.05	39.81	39.81
38.27	38.27	38.27

32

34

5 4

SOUTH

PERRY 33 T13

4


3

HOCKING COUNTY STATE OHIO

SEC 33 TWP 12 RANGE 19

PERRY TWP

NORTH

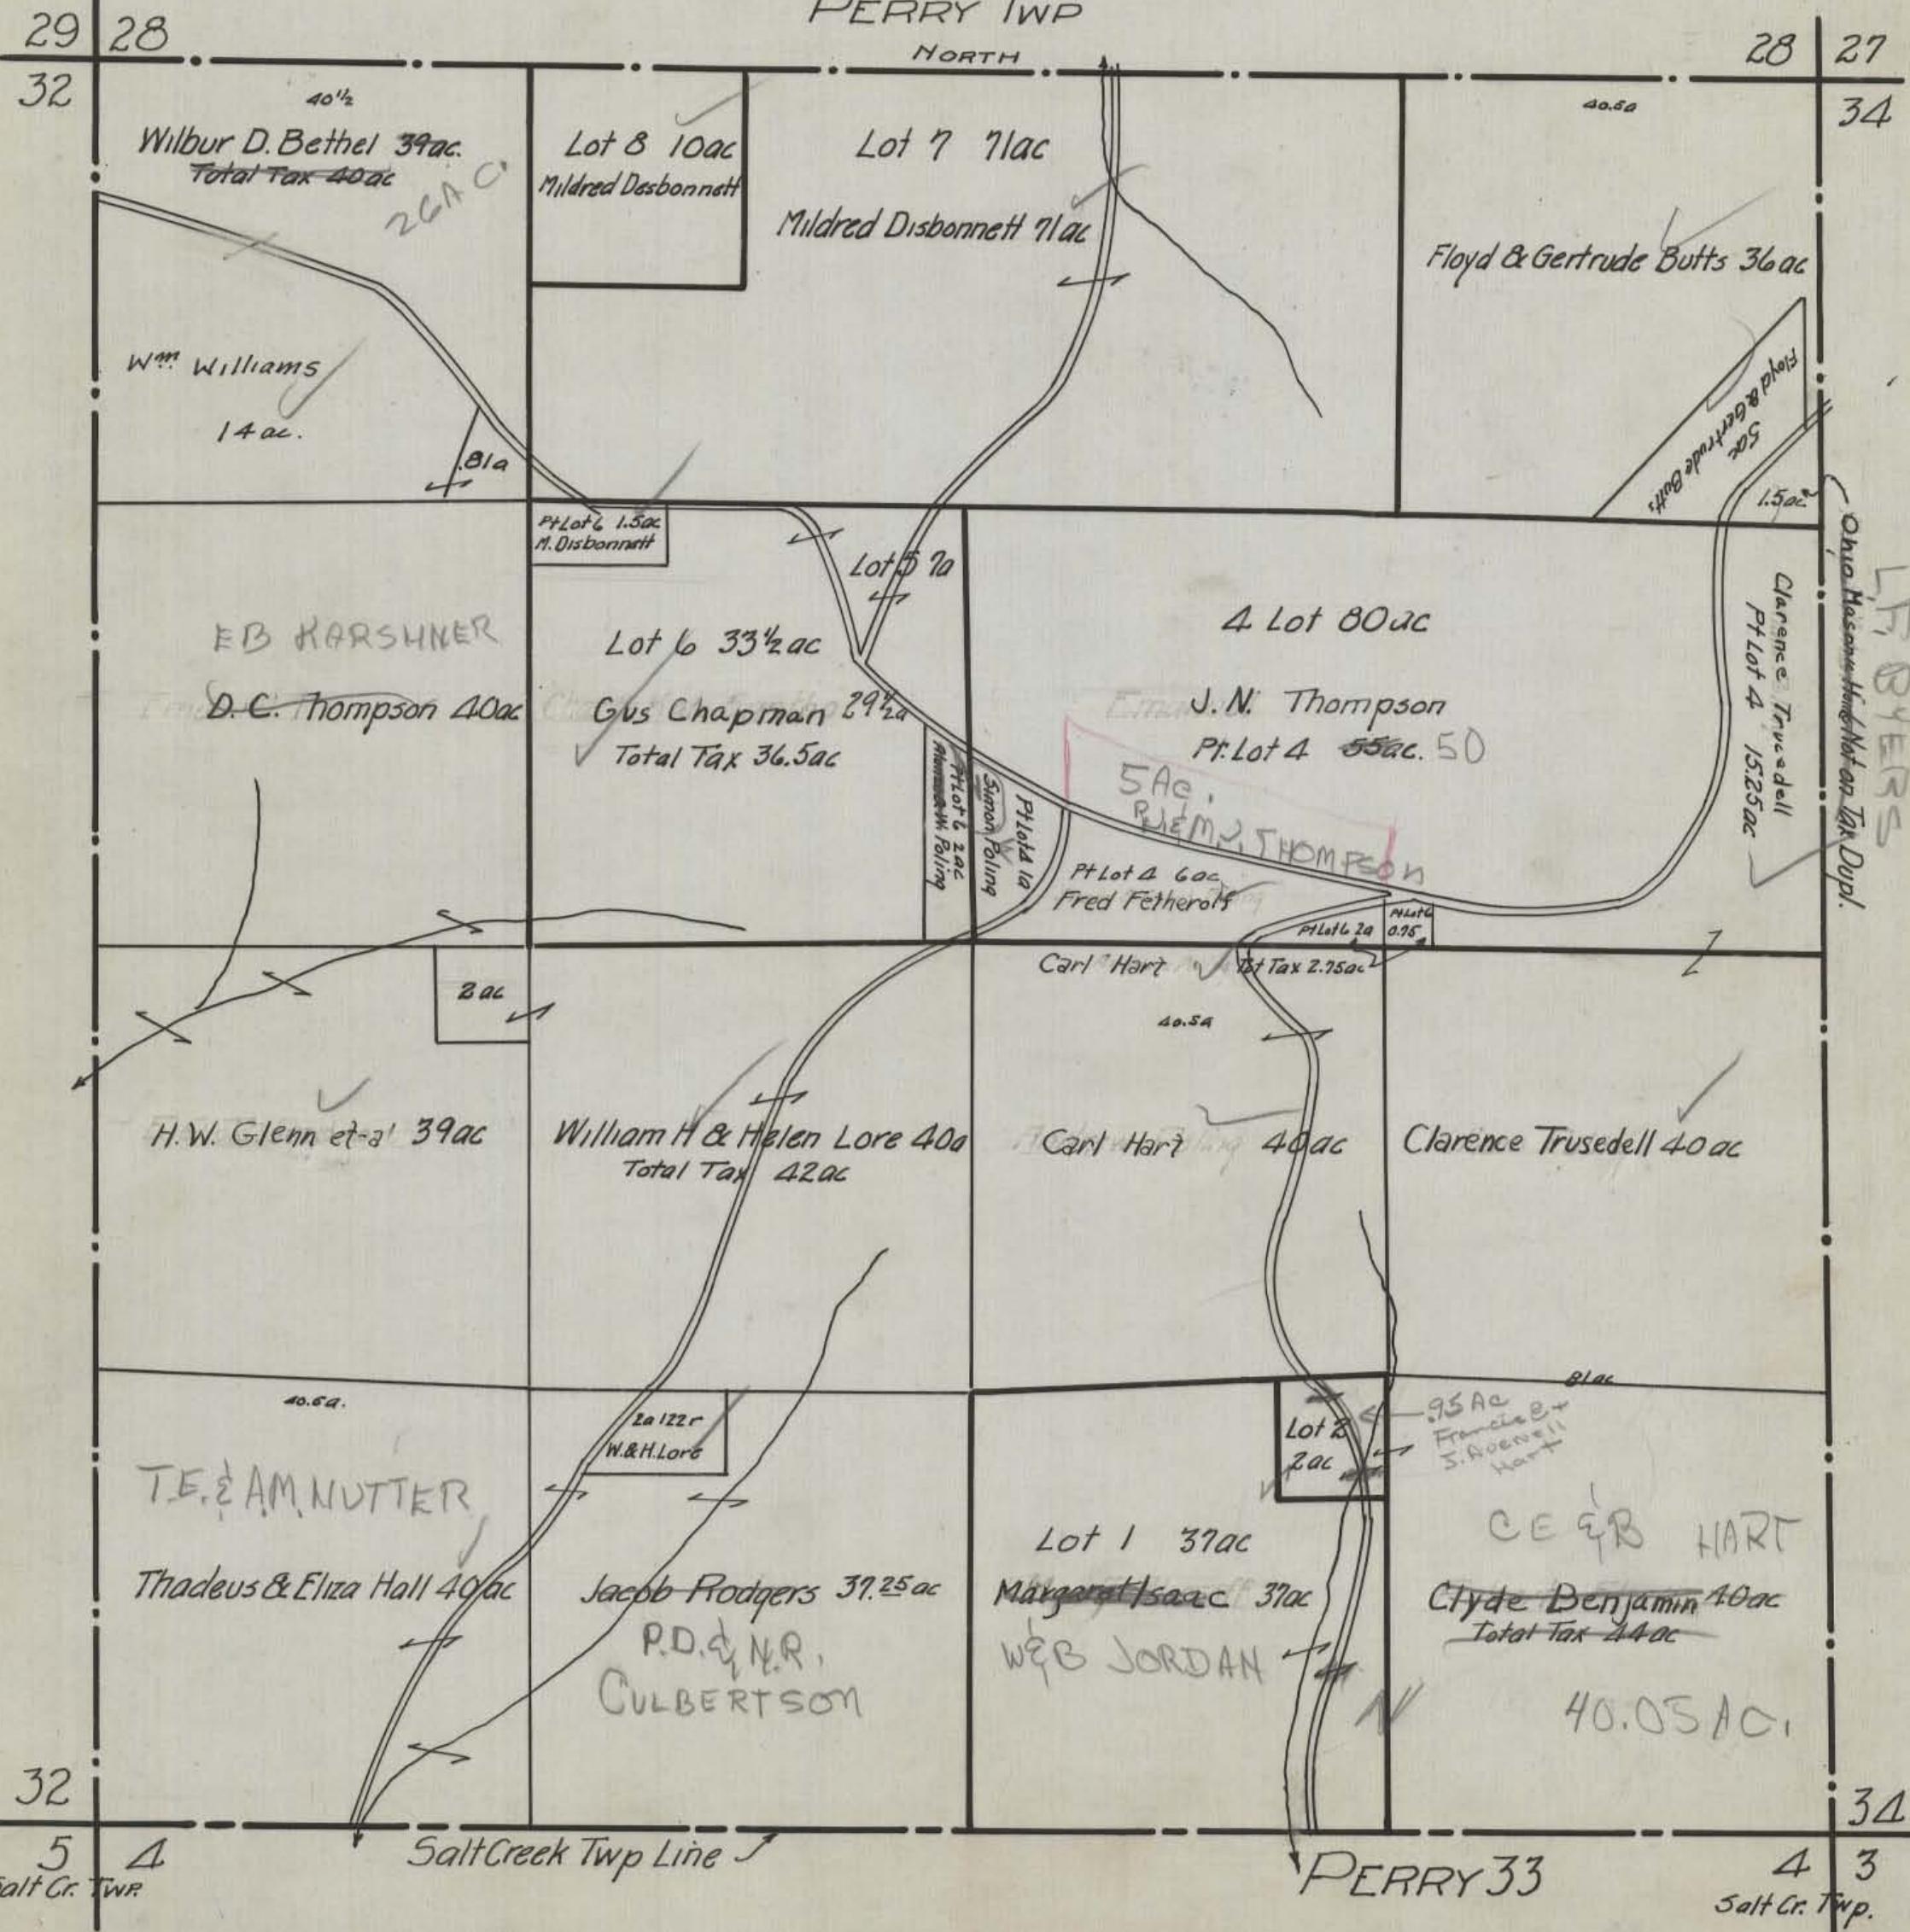

HOCKING COUNTY STATE OHIO
SECTION NO. 34 TWP. 13 RANGE 19
PERRY Twp 13

A.W.S Apr 19 1939

Madison Twp
Fairfield Co
28 27


NORTH

SCALE: 500 FEET TO 1 INCH

Madison Twp
Fairfield Co.
26

35

33

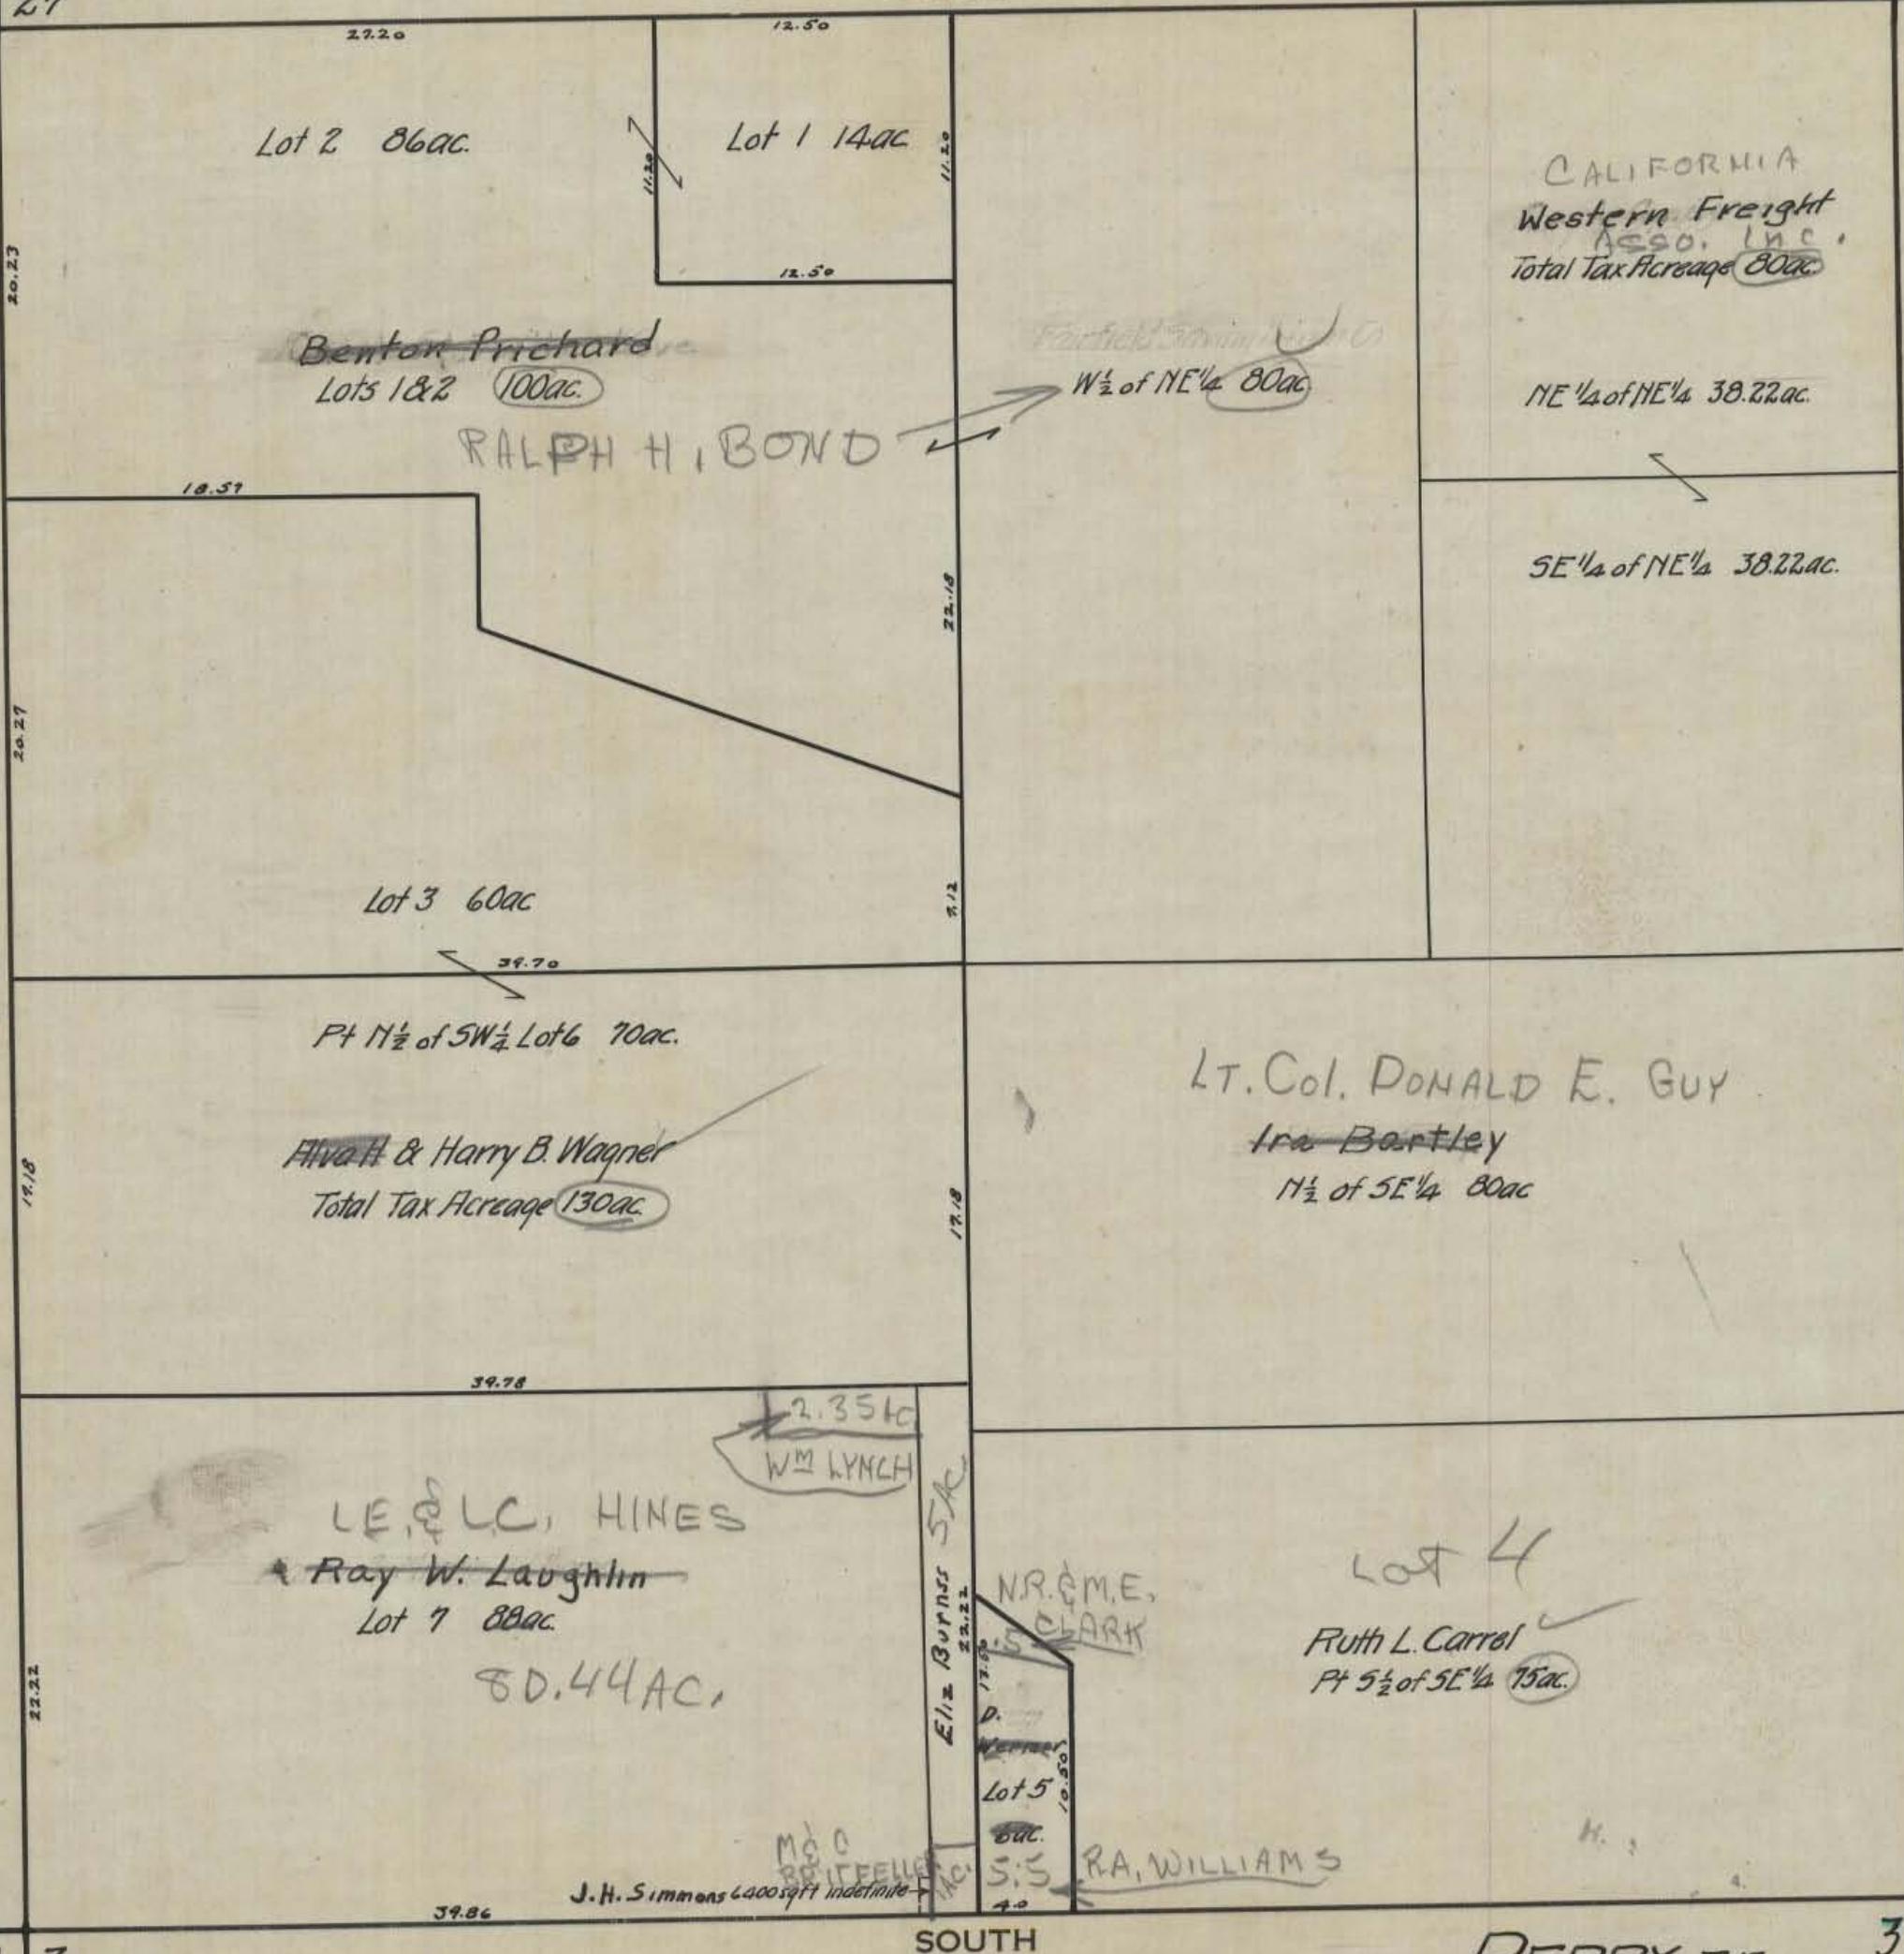

33

4 3

HOCKING COUNTY STATE OHIO

SEC. 34 TWP 12 RANGE 19
PERRY Twp.

Scale 1: 500

28 | 27

27

33

EP. & AJ

North

27

26

Geo. Reid
Pt Lot 4 39 1/2 ac

Claude H. Hest
Pt Lot # 5 ac.

Glarence Ingram
Pt Lot 4 4 1/2 ac

4.5
LOT 8 600
112225

Lot 7 75ac

Margaret Taffee 75ac
Total Tax Acreage 81ac

41ac.

L.F. BYERS

~~Ohio Masonic Home 40 ac
Total Tax Ac ~~4~~ ac.~~

LOT 1 36ac

E.P. INGRAM

~~Clarence Ingram~~ 40ac
Total Tax Acreage 45ac
(Deed in error)

201 3 5000

LOT 6 3a
R. F.

THELMA
Joe M. Smith & wife 80ac
Total Deed Acreage 124ac
Total Tax Acreage 120ac

Frank G. Sharp 40 ac

Frank C. Sharp 40ac

J.D. S.H.S.
H.H. Hartley 70ac

BERRY

Salt Creek Twp Line

PERRY 34

3 | 2

HOCKING COUNTY STATE OHIO
SECTION NO. 35 TWP. 13 RANGE 19

AWS Apr 22 1939

Madison Twp.
Fairfield Co.
27
26

PERRY T13.


NORTH

SCALE: 500 FEET TO 1 INCH


Madison Twp.
Fairfield Co.
25

34

* 36

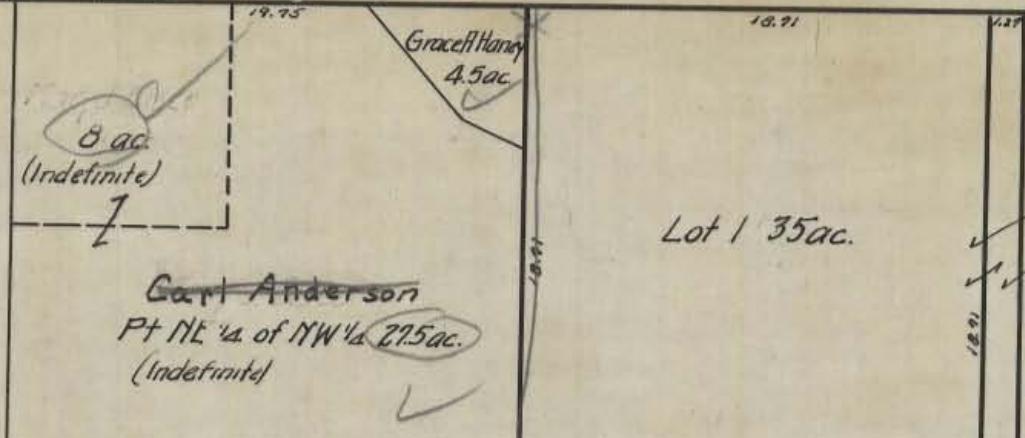


CALIFORNIA
Western Freight
E $\frac{1}{2}$ NE $\frac{1}{4}$ 80 ac. ASSO. Inc.
Total Tax Acreage 120 ac. ✓

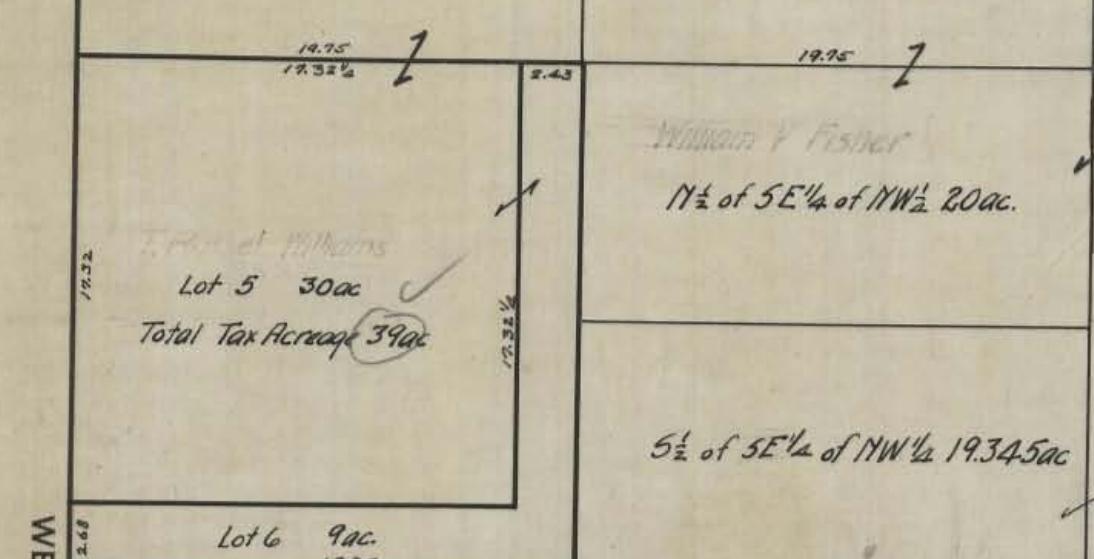

WEST

EAST

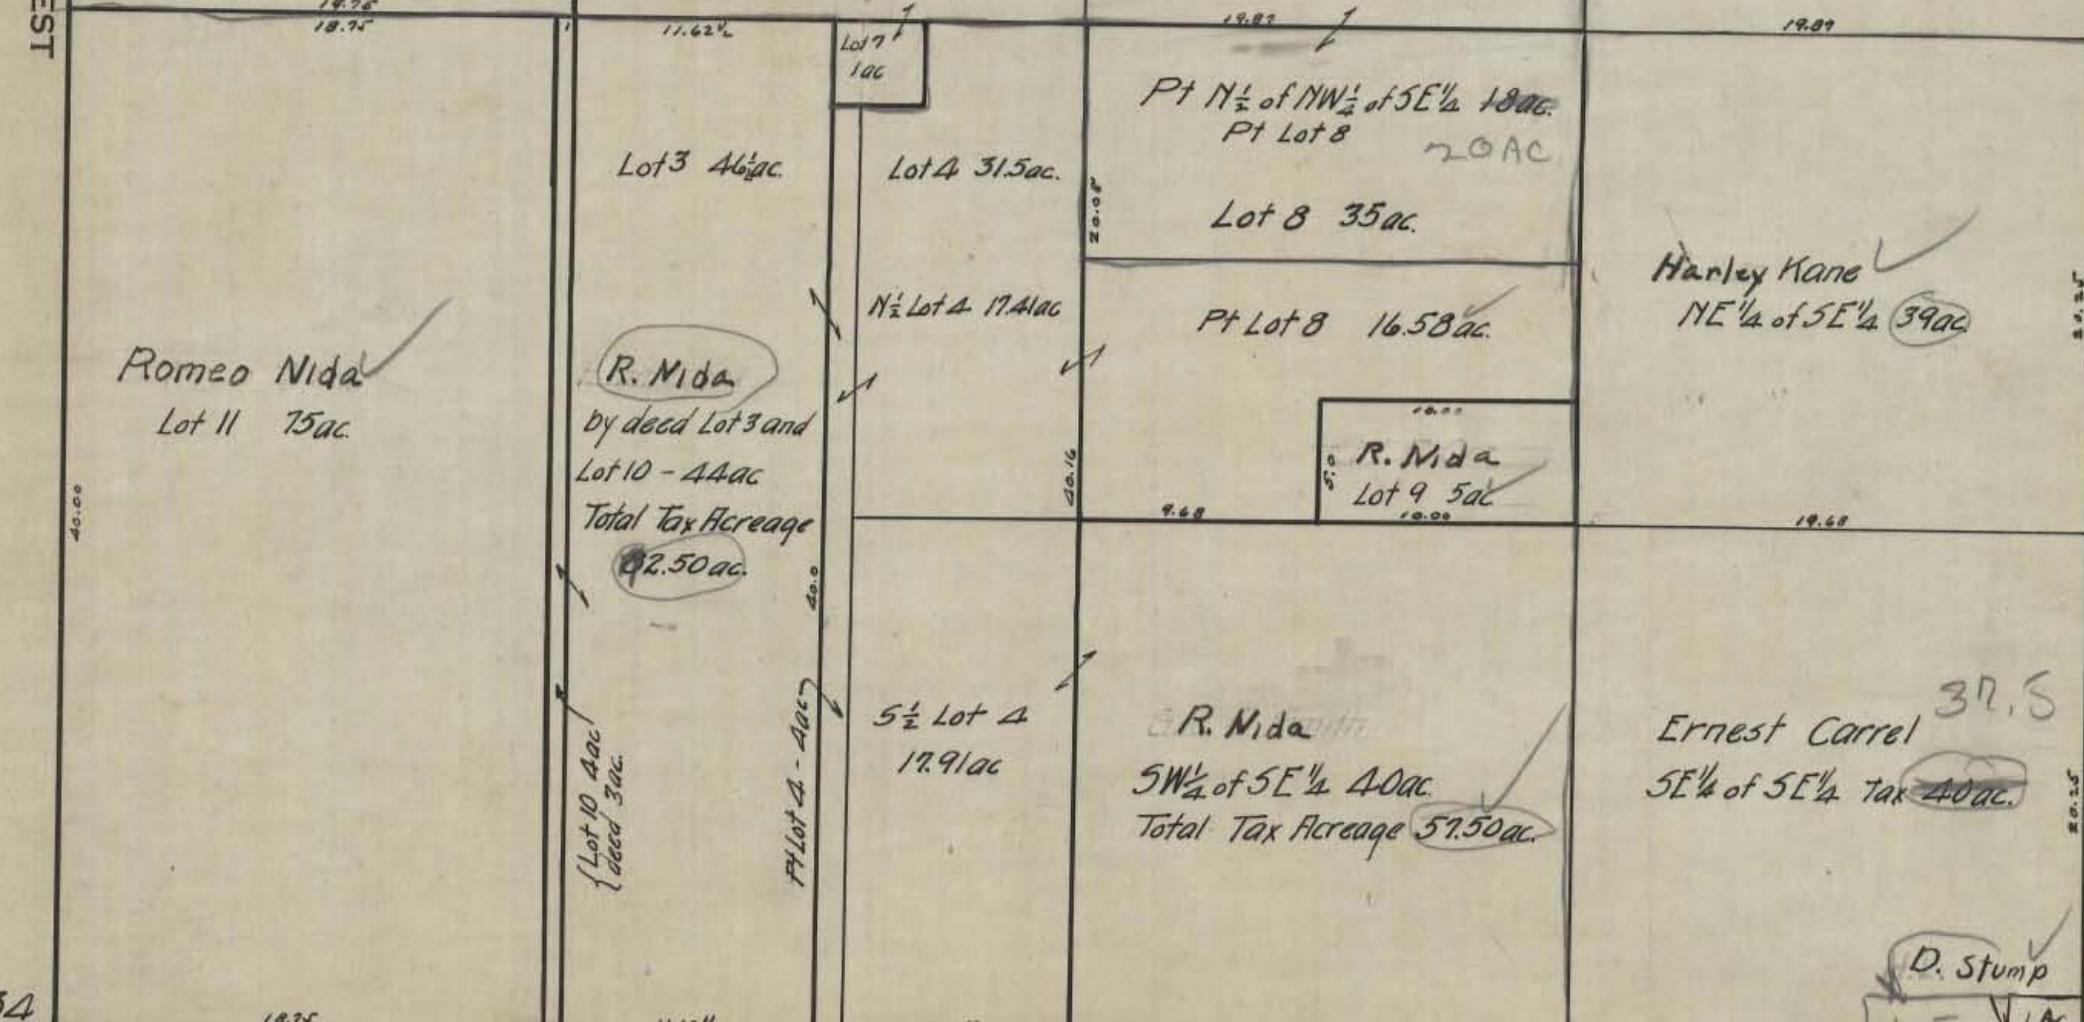

34

2

36

SOUTH

PERRY 35 T13

3

1

HOCKING COUNTY STATE OHIO

SEC. 35 TWP. 12 RANGE 19

PERRY TWP.



HOCKING COUNTY STATE OHIO
SECTION NO. 36 TWP. 13 RANGE 19

PERRY T 13.

NORTH

SCALE: 500 FEET TO 1 INCH

TWP. 30
31

26 25 A.W. Seabright Apr 29 1939.

Madison Twp Fairfield Co.

35

Louise King
NW $\frac{1}{4}$ of NW $\frac{1}{4}$ 40ac

Elmer Campbell
NE $\frac{1}{4}$ of NW $\frac{1}{4}$ 41.89ac

CALIFORNIA WESTERN
FREIGHT ASSN. INC.

Daniel F.E. Wingett
NW $\frac{1}{4}$ of NE $\frac{1}{4}$ 40ac

John Flowers

John Flowers
E $\frac{1}{2}$ of NE $\frac{1}{4}$ 19.92ac
(Tax Acreage 80ac) ✓

40.00

Marion Knappenberger
SW $\frac{1}{4}$ of NW $\frac{1}{4}$ 40ac

Western Freight
SE $\frac{1}{4}$ of NW $\frac{1}{4}$ 40ac

E.E. Springer
S.W $\frac{1}{4}$ of NE $\frac{1}{4}$ 41.73ac
Tax Acreage 40ac
HARLEY M. BAKER

40.0

20.0

20.0

Hanley Kane
PT NW $\frac{1}{2}$ SW $\frac{1}{4}$ 55ac

John Amos
Burgess
6ac
Undeveloped

Louis M. Cott
NE $\frac{1}{4}$ of SW $\frac{1}{4}$ 39.66ac.
Tax Acreage 40ac

E.E. Springer
NW $\frac{1}{4}$ of SE $\frac{1}{4}$ 40ac

W.E. Springer
PT NE $\frac{1}{4}$ of SE $\frac{1}{4}$ 39.50ac.

Sarah & Mary Jones 81sqrd →
HARLEY C. ROTH BAKER
.50

E.E. Springer
PT NW $\frac{1}{2}$ of SW $\frac{1}{4}$ 30ac.

HARLEY
KANE

PT SE $\frac{1}{4}$ of SE $\frac{1}{4}$ 10ac.

Note - According
to M.J. Carroll Deed
2ac tract is in this corner
& double tax entered

Mary J. Carroll
PT NW $\frac{1}{2}$ SW $\frac{1}{4}$ 18ac
Total Tax Acreage 20ac.

Dickson Stump
PT SE $\frac{1}{4}$ of SW $\frac{1}{4}$ 38ac

2ac

2ac

2ac

2ac

Hanley Kane
5 $\frac{1}{2}$ of SW $\frac{1}{4}$ 40ac.
Total Tax Acreage 50ac.

40.0

SOUTH

PERRY 36 T 13

31

1 6
Laurel Twp

35

2

31

HOCKING COUNTY STATE OHIO

SEC. 36 TWP. 12 RANGE 19
PERRY TWP.

