72526

RECEIVED IN HOCKING COUNTY, OHIO
at 11:26 O'CLOCK A M
RECORDED May 9 1988
RECORD Plat VOL. 6 PAGE 53

MAY 09 1988

Donna R. Leach
RECORDER - HOCKING COUNTY
LOGAN, OHIO 43138

DOOR SCHEDULE

NO.	SIZE	DOOR MAT.	DOOR FINISH	FRAME MAT.	FRAME FINISH	HARDWARE	REMARKS
100	3'-0"X6'-8" EXIST.	WOOD	PAINT	WOOD	PAINT	EXIST.	
101A,B	2'-8" X 6'-8" X 1 3/4"	"	"	"	"	LOCKSET & CLOSER	
102	3'-0" X 6'-8" EXIST.	"	"	"	"	EXIST.	
103	2'-8" X 6'-8" X 1 3/4"	"	"	"	"	PRIVACY SET	
104 A,B	2'-6" X 6'-8" X 1 3/4"	"	"	"	"	LOCKSET	
104 C,D	2'-8" X 6'-8" X 1 3/4"	"	"	"	"	LOCKSET	
105A,B	2'-6" X 6'-8" X 1 3/4"	"	"	"	"	LOCKSET	
109 A,B	2'-6" X 6'-8" EXIST.	"	"	"	"	EXIST.	
110	2'-8" X 6'-8 EXIST.	"	"	"	"	EXIST.	
111	3'-0" X 6'-8" X 1 3/4"	"	"	"	"	LOCKSET & CLOSER	
112	2'-8" X 6'-8" X 1 3/4"	"	"	"	"	LOCKSET	
113	3'-0" X 6'-8" EXIST.	"	"	"	"	EXIST.	
115A,B	2'-6" X 6'-8" EXIST.	"	"	"	"	EXIST.	
116	" " "	"	"	"	"	EXIST.	
117	3'-0" X 6'-8" X 1 3/4"	"	"	"	"	LOCKSET & CLOSER	

ROOM FINISH SCHEDULE

NO.	NAME	FLOOR CARPET	FLOOR VINYL	BASE WOOD	BASE VINYL	WALL DRYWALL	CEILING DRYWALL	CEILING DRY-WALL LAY-IN CEILING	HT.	REMARKS
100	VESTIBULE	O		O		O		O	8'-0" EXISTING TO BE MAINTAINED	
101	WAITING ROOM	O		O		O		O		
102	OFFICE	O		O		O		O		
103	PATIENT TOILET		O		O	O	O			
104A-C	EXAM ROOMS		O		O	O	O			
105A,B	NURSING STATIONS		O		O	O	O			
106	CORRIDOR	O		O		O	O			
107	CONSULTATION	O		O		O	O			
108	VESTIBULE	O		O		O	O			
109 A,B	TOILET ROOMS		O		O	O	O			
110	WAITING ROOM	O		O		O	O			
111	OFFICE	O		O		O	O			
112	LAB		O		O	O	O			
113	CORRIDOR	O		O		O	O			
114	NURSES STATION		O		O	O	O			
115A,B	EXAM ROOMS		O		O	O	O			
116	CONSULTATION	O		O		O	O			
117-125	EXIST. ROOMS									

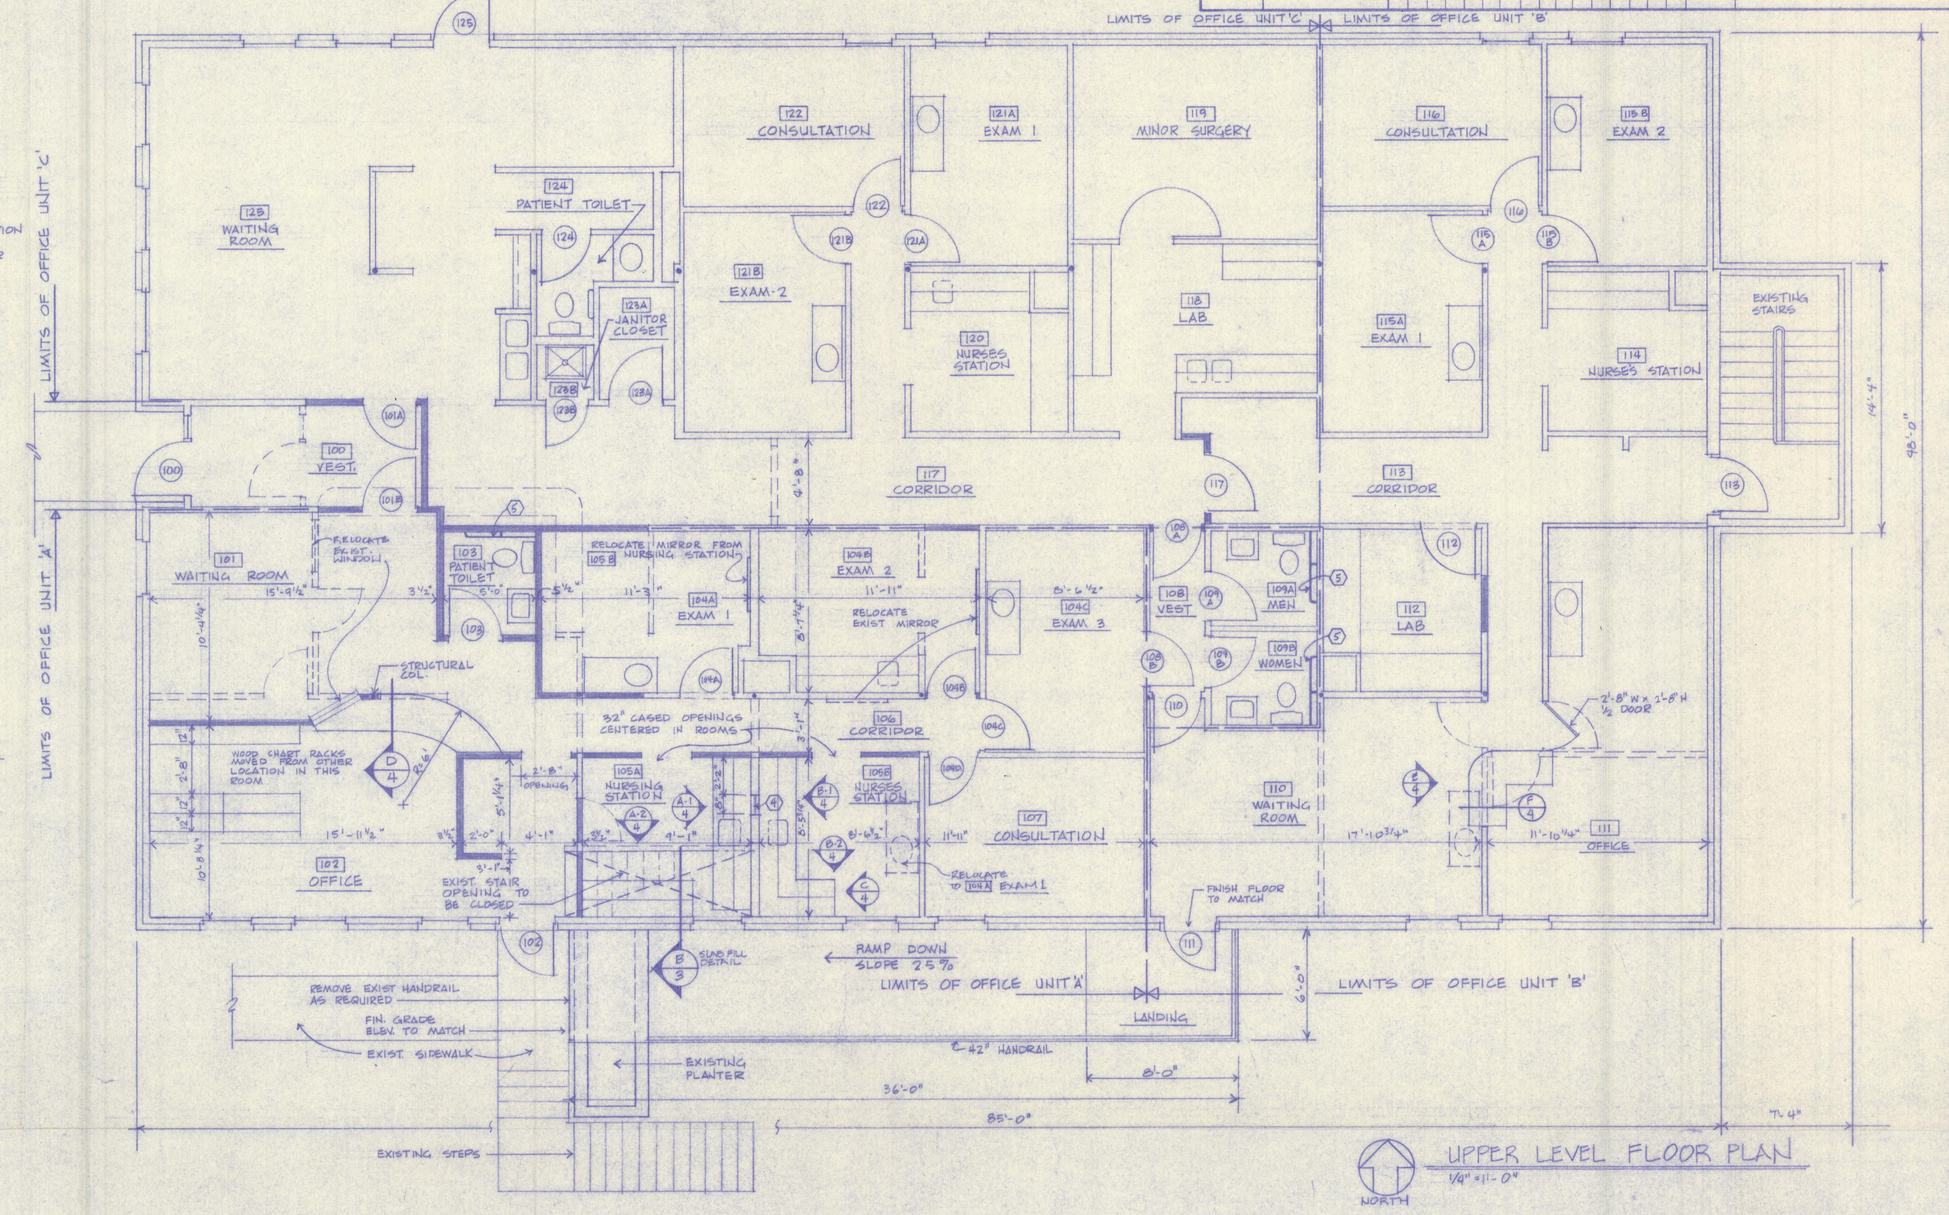

UPPER LEVEL FLOOR PLAN
1/4" = 1'-0"

FLOOR PLAN NOTES

1. DIMENSIONS ARE TO ROUGH UNLESS NOTED OTHERWISE. DIMENSIONS ARE BASED UPON ORIGINAL BUILDING DRAWINGS; ACTUAL FIELD MEASUREMENTS MAY DIFFER
2. FIRE EXTINGUISHER BY OWNER TYPE A,B,C, - 5 lb 5 lb. CAPACITY
3. PATCH EXISTING WALL, CEILING AND FLOOR CONSTRUCTION AT LOCATIONS WHERE EXISTING IS REMOVED. FINISH TO MATCH AND ALIGN WITH EXISTING FINISH TO EITHER OF PATCH AREA
4. 8" x 8" PASS THRU, SILL AT 43" ABOVE FIN. FLR.
5. GRAB BAR - MTD. 33" A.F.F. - 42" LONG

OFFICE AREA ANALYSIS: UPPER LEVEL

UNIT "A"	1138 S.F.
UNIT "B"	1106 S.F.
UNIT "C"	1030 S.F.

CERTIFICATION

TO THE BEST OF MY KNOWLEDGE THE DRAWINGS ACCURATELY SHOW THE BUILDING AS CONSTRUCTED.

JAMES A. MONSUL - ARCHITECT • REG. NO. 4889
4-5-88

KEY

- EXISTING PARTITION - WOOD STUD W/ 1/2" DRYWALL BOTH SIDES
- NEW PARTITION - WOOD STUD W/ 1/2" DRYWALL BOTH SIDES
- EXISTING TO BE REMOVED OR RELOCATED

53

James A Monsul & Assoc. ARCHITECTS
201 South Broad Street Lancaster, Ohio 43130 (614) 687-5597

FLOOR PLAN

ALTERATIONS TO EXISTING
PHYSICIAN'S OFFICE BUILDING

751 STATE ROUTE 664 NORTH
LOGAN, OHIO 43138
FOR THE HOCKING COUNTY COMMUNITY IMPROVEMENT CORP.
P.O. BOX 836, LOGAN, OHIO 43138

STATE OF OHIO
JAMES A. MONSUL
4889
REGISTERED ARCHITECT

82203

12 - 13 - 82

2